

MISSISSIPPI BOARD OF WATER COMMISSIONERS

D 23  
7-29-63

WATER WELL DRILLERS LOG

D 23  
7-29-63

Date: July 29, 1963 Driller: C. D. Thornton County: Copiah

(1) Owner of Land: City of Crystal Springs  
(Name)

Crystal Springs, Mississippi  
(Address)

(2) Location: General vicinity of existing municipal waterworks plant  
Location: 1/2 mi. S. 1/4 Sec. 25, T. 22 N., R. 22 W.  
municipal waterworks plant  
miles \_\_\_\_\_ of \_\_\_\_\_  
(distance) (direction) (Nearest Town)

(3) Topography: \_\_\_\_\_  
(Hilly) (Flat) (Level)

(4) Purpose of Well: Municipal  
(Domestic, Irrigation, Municipal, Industrial, Other)

Description & Color of Materials  
Sand, Clay, Red Clay, Shell, etc.

Thick-  
ness  
Feet

Depth  
Feet

Gravel & Clay  
Sand & Gravel, good W.B.  
Rock  
Clay

84  
23  
4  
5

84  
107  
111  
116

**Abandoned**

Information upon completion of well:

(1) Diameter: 36 inches

(2) Total Depth: 107 feet

(3) Water Level: 62 feet below top of ground

(4) Cased to: 87' Size: 36"


(5) Screen: Size: 12" Length: 20'

(6) Were any formations sealed against pollution?  
 yes,  no

If YES depth of formation: \_\_\_\_\_

Why: Casing cemented from top to bottom with neat cement grout.

Drillers Remarks: \_\_\_\_\_

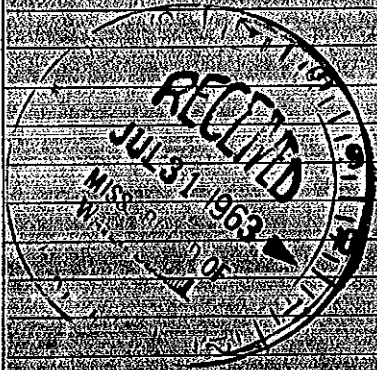

(Use Back Side)

Well No.

Retain this copy for your office files.