

COPIAH MISSISSIPPI BOARD OF WATER COMMISSIONERS

D 24  
7-3-62

WATER WELL DRILLERS LOG

MCS  
D 19


Date July 3, 1962, Driller Binney Jester, Health Sanitary County, Copiah  
(Name)

(1) Owner of Land: Jack Conn  
(Name)  
Crystal Springs, Miss.  
(Address)  
Dees Road  
(2) Location: 27 2N/1W  
2 1/2 miles SW of Crystal Spgs.  
(distance) (direction) (Nearest Town)  
(3) Topography: Hilly  
(Hilly) (Flat) (Level)  
(4) Purpose of Well: Domestic  
(Domestic) (Irrigation) (Municipal) (Industrial) (Other)

Description & Color of Material (Sand, Clay, Red Clay, Shell, etc.)	Thickness (Feet)	Depth (Feet)
Topsoil & red clay	12	12
Red sand	28	40
White clay	10	50
Water bitumens & rock	5	55
Rock & blue clay	20	75
Hard & soft formations	21	96
Layers limest. & shale	101	197
Layers fine sand	4	201
Blue & brown shale	38	239
Layers fine sand	11	250
Layers shale & sand	37	287
Black shale	11	298
Rock & black shale	31	329
Layers fine sand	26	355
Fine sand	40	395
Shale & Rock	6	403

Information upon completion of well:

(1) Diameter: 6 inches  
(2) Total Depth: 403 feet  
(3) Water Level: 162 feet below top of ground  
(4) Cased to: 378' size: 196'-4" / 182'-2"  
(5) Screen: Size: 2" Length: 15'  
(6) Were any formations sealed against pollution?  
 yes  no  
If YES depth of formation: From surface  
Why To prevent surface pollution  
Drillers Remarks: Used Sanitary well seal

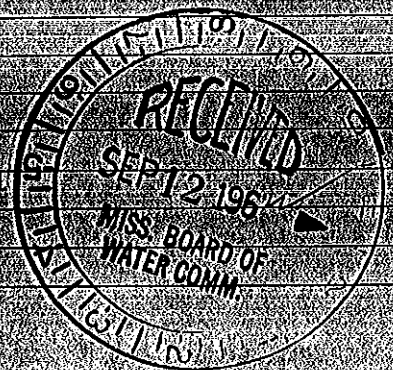

Well No

Mail this copy to Board of Water Commissioners 429 Miss. St. Jackson, Miss.