

Copiah  
021  
3-67

MISSISSIPPI  
 BOARD OF WATER COMMISSIONERS  
 416 North State Street  
 Jackson, Mississippi 39201  
 WATER WELL DRILLERS LOG

CODED

March 13, 1967 Birney Water Well Service, Inc. Copiah  
 date well completed firm name county well located

LANDOWNER: John A. Thornton  
Route 3

description of formations encountered	depth	
	from	to
Red Top soil	0	6
Gravel & red sand	6	19
Sand clay & gravel	19	78
Pipe clay & sand	78	87
Coarse sand & pea gravel	87	102


Crystal Springs, Miss.  
 (mailing address)

WELL LOCATION:  
 sec. 33T 2 N R. 2 E  
5 miles West of C. S.  
 (distance) (direction) (nearest town)

WELL PURPOSE: Home  
 (home, irrigation, municipal, industrial)

WELL COMPLETION DATA:

- (1) diameter (inches) 6 3/4
- (2) total depth (feet) 102
- (3) static water level (feet) 70 below top of ground
- (4) casing PVC 1 1/2 (material) (diameter)  
no (if telescope see back) (size)
- (5) screen 6' 9/16" (length) (diameter)  
1/8" (size) (material) (material)
- (6) pump 1 300 GPM (HP) (yield gpm)  
Electric (type power)
- (7) electric log No (yes or no)  
 (organization running log)
- (8) how well bottom plugged: Back wash valve used

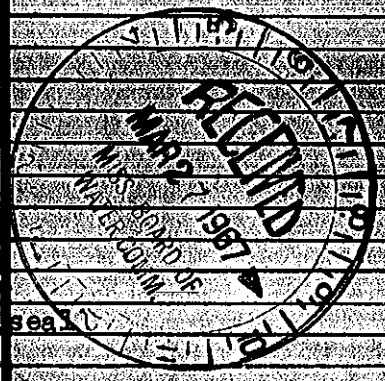

DRILLERS REMARKS: Sanitary well seal  
water used