

Copied
 D 30
 8-25-68

MISSISSIPPI
 BOARD OF WATER COMMISSIONERS
 416 North State Street
 Jackson, Mississippi 39201

CODED

WATER WELL DRILLERS LOG

8-25-1967 date well completed
 2297 6805 firm name
 Copied county well located

LANDOWNER: *Mississippi Federated Cooperatives, Crystal Springs, Miss*
 (mailing address)

description of formations encountered	from	to
Top Soil	0	1
SANDY CLAY GRAVEL	1	18
CLAY GRAVEL	18	35
SANDY CLAY	35	40
SAND & PEG GRAVEL	40	50
PEG GRAVEL + CLAY STRS	50	58
HARD PACKED SAND	58	102
ROCK	102	103


WELL LOCATION:
 sec. 35 T. 2 N. R. 2 E.
 S. W.
 2 miles South of Crystal Springs
 (distance) (direction) (nearest town)

WELL PURPOSE: *Plant*
 (home, irrigation, municipal, industrial)

WELL COMPLETION DATA

- (1) diameter (inches) 18"
- (2) total depth (feet) 102'
- (3) static water level (feet) 36' below top of ground.
- (4) casing Steel 79'
 (material) (depth)
 (size) If telescope see back.
- (5) screen 20' 79'
 (length) (depth to top)
3" stainless steel
 (size) (material)
- (6) pump 25 250
 (HP) (yield gpm)
Electric
 (type power)
- (7) electric log no
 (yes or no)
 (organization running log)
- (8) how well bottom plugged solid
Bottom

CODED

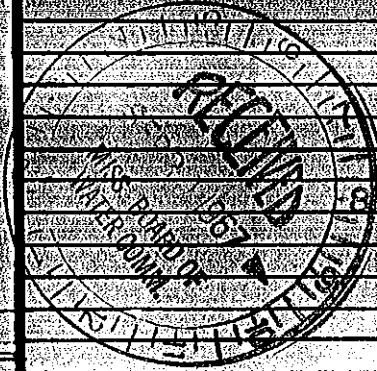

DRILLERS REMARKS: