

COPIA
D35
2-9-61

MISSISSIPPI BOARD OF WATER COMMISSIONERS

WATER WELL DRILLERS LOG


Date: Feb. 9 1961, Driller: Benney Latta Well Serv. Co., Conlan
(Benney & Son)

(1) Owner of Land: Ben Benney
(Name)
Crystal Springs, Miss.
(Address)
Bunney Road
(2) Location: 34 2 20
1/4 Sec. T. R.
3 miles SW of Crystal Spgs.
(distance) (direction) (Nearest Town)
(3) Topography: Hilly
(Hilly) (Flat) (Level)
(4) Purpose of Well: Domestic
(Domestic) (Irrigation) (Municipal) (Industrial) (Other)

Description & color of Material (Sand, Clay, Red Clay, Shell, etc.)	Thickness (Feet)	Depth (Feet)
Red Topsoil	6	6
Red sand	59	65
Layers gravel & clay	44	109
Pea gravel & sand	6	115
Layers sand & clay	13	128
Rock	1	129
Layers sand & clay	9	138
Rock (sand)	1	139
Grey clay	3	142

Information upon completion of well:

(1) Diameter: 6 inches
(2) Total Depth: 142 feet
(3) Water Level: 94 feet below top of ground
(4) Cased to: 132 Size: 4"
(5) Screen Size: 20 Length: 10'
(6) Were any formations sealed against pollution?
yes no
If YES depth of formation: From surface
Why: To prevent surface pollution
Drillers Remarks:

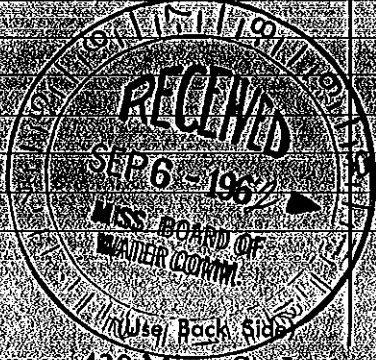

Well No.

Mail this copy to Board of Water Commissioners 429 Miss. St. Jackson, Miss.