

D 38
5-3-65


WATER WELL DRILLERS LOG

Date: May 3, 1965, Driller: Bimney Water Well S County: Copiah
(Name)

CODED

(1) Owner of land: Irene Wiley
(Name)
Route 2, Crystal Springs, Miss.
(Address)
Highway 51 South
(2) Location: 1/4 NE 1/4 Sec 26 T. 10 N. R. 10 W.
2 miles south of Crystal Springs
(distance) (direction) (Nearest Town)
(3) Topography: hilly
(Hilly) (Flat) (Level)
(4) Purpose of Well: Domestic
(Domestic Irrigation, Municipal, Industrial, Other)

Description & Color of Materials Sand, Clay, Red Clay, Shell, etc.	Thickness Feet	Depth Feet
Red topsoil	11	11
Red sand	11	22
Gravel & sand	24	46
Gravel & pipe	6	52
Water & pipe	18	70

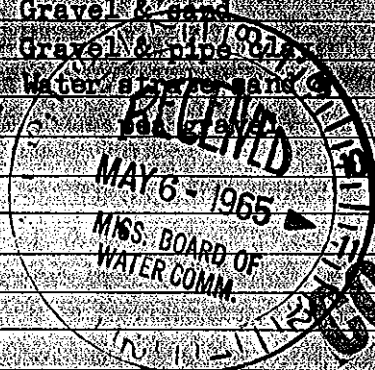

Information upon completion of well:

(1) Diameter: 4 inches.
(2) Total Depth: 70 feet.
(3) Water Level: 38 feet below top of ground.
(4) Cased to: 65' Size: 2"
(5) Screen: Size: 28" Length: 5'
(6) Were any formations sealed against pollution?
 yes, no.
If YES depth of formation: From surface
Why to prevent surface pollution:
Drillers Remarks:

CODED
CODED
CODED

(Use Back Side)

Well No.