

OPIAH

MISSISSIPPI BOARD OF WATER COMMISSIONERS

D 42

4-12-66

WATER WELL DRILLERS LOG

Date: Apr 11 12, 1966 Driller: Burney Water Well Ser. Inc. Co. Copiah

(Name)

CODED

(1) Owner of Land: Andrus B. Neill  
 (Name)  
Crystal  
 (Address)

(2) Location: 1/4 NW 1/4 Sec 31 2N 2W  
2 1/2 miles East of Dentville  
 (distance) (direction) (Nearest Town)

(3) Topography: Hilly  
 (Hilly) (Flat) (Level)

(4) Purpose of Well: Domestic  
 (Domestic Irrigation) (Municipal) (Industrial) (Other)

Description & Color of Material Sand, Clay, Red Clay, Shell, etc.	Thickness (Feet)	Depth Feet
Fill dirt & top soil	5	5
Multicolored clay	15	20
Fine sand layers	3	23
All fine sand	4	27
Hard grey clay	4	31
Yellow sand	16	47
Blue clay	18	65
Fine blue sand in layers	21	86
Blue shale or clay	24	110
All fine blue sand	20	130
Sand & clay layers	12	142

Information upon completion of well:

(1) Diameter: 6 1/2 inches.

(2) Total Depth: 142 feet.


(3) Water Level: 65 feet below top of ground.

(4) Cased to: 125' Size: 2 1/2"

(5) Screen: Size: 2 1/2" Length: 7'

(6) Were any formations sealed against pollution?  
 yes,  no.

CODED

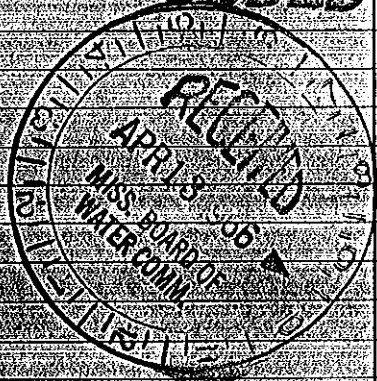

If YES depth of formation from surface \_\_\_\_\_

Why to prevent surface pollution \_\_\_\_\_

Drillers Remarks: Sanitary well seal used

Well No.

(Use Back Side)

Mail this copy to Board of Water Commissioners 429 Miss. St. Jackson, Miss.