

COPIAH MISSISSIPPI BOARD OF WATER COMMISSIONERS

DA7
6-5-64

WATER WELL DRILLERS LOG

CODED

Date: June 5, 1964 Driller: Burney Water Well Serv. Co., Copiah
(Name)


(1) Owner of Land: W. A. Chandler
(Name)
279 S. Jackson Street
(Address)
City Limit Rd. 3 1/4 Sec. 26 Lot 2
(2) Location:
1 1/2 miles south of Crystal Spgs.
(distance) (direction) (Nearest Town)
(3) Topography: Hilly
(Hilly) (Flat) (Level)
(4) Purpose of Well: Domestic
(Domestic, Irrigation, Municipal, Industrial, Other)

Description & Color of Materials Sand, Clay, Red Clay, Shell, etc.	Thickness Feet	Depth Feet
Red clay top soil	10	10
Sand and gravel	30	50
Pea gravel	25	65
White sand	17	82

Information upon completion of well:

(1) Diameter: 4 inches.
(2) Total Depth: 82 feet.
(3) Water Level: 36 feet below top of ground.
(4) Cased to: 72 Size: 2 1/2
(5) Screen: Size: 2 1/2 Length: 5'
(6) Were any formations sealed against pollution?
no yes, no.

CODED

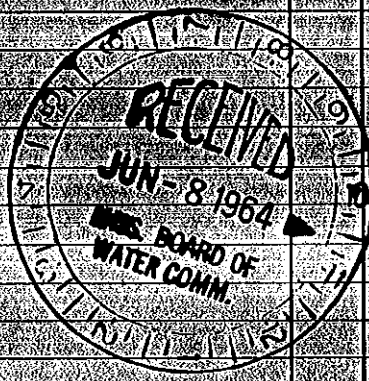

If YES depth of formation: 8'
Why? to prevent surface pollution
Drillers Remarks:

Well No.

(Use Back Side)

Retain this copy for your office files.