

COPAH MISSISSIPPI BOARD OF WATER COMMISSIONERS

D 2008
1-4-62

WATER WELL DRILLERS LOG

Date: Jan 4 19 62, Driller: Burney Water Well Serv County Copiah

(Name)

(1) Owner of Land: W. M. Singletary
(Name)

Crystal Springs, Miss
(Address)
Burney Road

(2) Location: $\frac{1}{4}$ Sec. 34 22 W
3 miles SW of Crystal Springs
(distance) (direction) (Nearest Town)

(3) Topography: Hilly
(Hilly) (Flat) (Level)

(4) Purpose of Well: Domestic
(Domestic, Irrigation, Municipal, Industrial, Other)

Description & Color of Material Sand, Clay, Red Clay, Shell, etc.	Thickness Feet	Depth Feet
Topsoil & clay	8	8
Red sand & clay	92	70
Clay gravel	12	52
Weak water strata	8	60
Red sand & gravel	20	80
Pea gravel & white sand	18	98
Rock	2	100
Clay	2	102

Information upon completion of well:

(1) Diameter 6 inches.


(2) Total Depth 102 feet.

(3) Water Level 79 feet below top of ground.

(4) Cased to 97' Size 90' 4"
7 1/2"

(5) Screen Size 20 Length 5'

(6) Were any formations sealed against pollution?
X yes, no

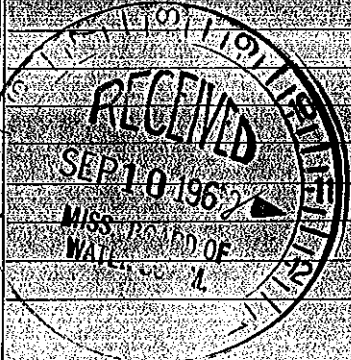

(Use Back Side)

Well No

Mail this copy to Board of Water Commissioners 429 Miss. St. Jackson, Miss