


COPIA MISSISSIPPI BOARD OF WATER COMMISSIONERS

D 709
10-29-62

WATER WELL DRILLERS LOG

Date Oct. 29, 1962 Driller Emory Water Well Serv. County Cochran

(1) Owner of land: Ralph Brown (Name) Crystal Springs, Miss. (Address)		Description & Color of Materials (Sand, Clay, Red Clay, Shell, etc)	Thickness (Feet)	Depth (Feet)
(2) Location: Rhymes Road 12 22 W 1/4 Sec 22 W		Sand, Topsoil & fine gravel	20	20
(3) Topography: Level (Hilly) (Flat) (Level)		Blue clay	22	42
(4) Purpose of Well: Domestic (Domestic, Irrigation, Municipal, Industrial, Other)		Fine sand	3	45
(1) Diameter: 4 inches.		Blue clay	20	65
(2) Total Depth: 184 feet.		Layers fine sand	3	68
(3) Water Level: 24 feet below top of ground.		Layers sand & clay	12	80
(4) Cased top: 169' Size: 2"		Blue & black shale	35	115
(5) Screen: Size: 2" Length: 5'		Rock formation	7	122
(6) Were any formations sealed against pollution? No		Soft blue formation	16	138
If YES depth of formation: From surface		Rock	1	139
Why to prevent surface pollution:		Blue clay	4	143
Drillers Remarks: Sanitary seal used		Layers fine sand	4	147
		Hard rock formation	2	149
		Hard black shale	8	157
		Very hard rock	8	165
		Black shale	3	168
		All Sand	16	184

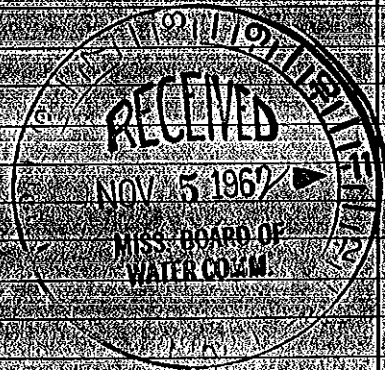

(Use Back Side)

Well No

Mail this copy to Board of Water Commissioners 429 Miss. St. Jackson, Miss.