


D 2010
1-17-63

WATER WELL DRILLERS LOG

Date Jan. 11, 19 63, Driller Burney Water Well Serv. Co. County Copiah

(Name)

(1) Owner of Land: <u>W. T. Day</u> (Name)	Description & Color of Materials Sand, Clay, Red Clay, Shell, etc.	Thickness Feet	Depth Feet
<u>Route 1, Crystal Springs, Miss.</u> (Address)	<u>Red topsoil</u>	<u>5</u>	<u>5</u>
<u>Hembree Road-New Highway 28</u>	<u>Clay gravel & red sand</u>	<u>57</u>	<u>62</u>
(2) Location: <u>1/4 Sec 13 2 2W</u>	<u>White clay & sand</u>	<u>19</u>	<u>81</u>
<u>3 miles North</u> of <u>Crystal Springs</u> (distance) (direction) (Nearest Town)	<u>Tight grey clay</u>	<u>17</u>	<u>98</u>
(3) Topography: <u>Hilly</u> (Hilly) (Flat) (Level)			
(4) Purpose of Well: <u>Domestic</u> (Domestic Irrigation Municipal, Industrial, Other)			
Information upon completion of well:			
(1) Diameter <u>8</u> inches			
(2) Total Depth <u>98</u> feet			
(3) Water Level <u>52</u> feet below top of ground			
(4) Cased to <u>74'</u> Size <u>4"</u>			
(5) Screen: Size <u>1/4"</u> Length <u>7'</u>			
(6) Were any formations sealed against pollution?			
<u>X</u> yes <u>no</u>			
If YES depth of formation from surface			
Why to prevent surface pollution			
Drillers Remarks: <u>Sanitary well seal used</u>			

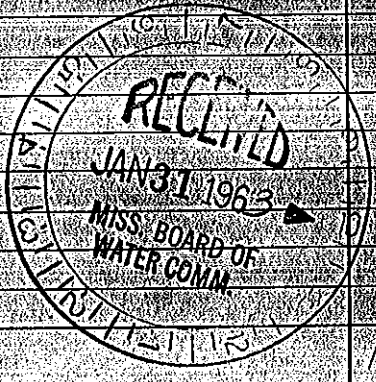

Well No

(Use Back Side)