

COPIA

MISSISSIPPI BOARD OF WATER COMMISSIONERS

E 12

WATER WELL DRILLERS LOG

C. D. ...

6-24-66

Date: June 24, 1966 Driller: Burney Water Well Service

(Name)

(1) Owner of Land: Sgt. Gerald D. Siegal
(Name)

Description & Color of Materials
Sand, Clay, Red Clay, Shell, etc.

Thick-
ness
Feet

Depth
Feet

Red clay & gravel

4

4

Grey clay

16

20

Blue clay

19

39

Layers of fine sand

26

65

All medium sand

13

78

Shale

18

96

325 Girard Drive

Crystal Springs, Miss.

(2) Location: 3/4 Sec 2 T W R

4 miles east of G. S.
(distance) (direction) (Nearest Town)

(3) Topography: Hilly
(Hilly) (Flat) (Level)

(4) Purpose of Well: Domestic
(Domestic Irrigation
Municipal, Industrial, Other)

Information upon completion of well:

(1) Diameter: 4 1/2 inches

(2) Total Depth: 96 feet

(3) Water Level: 50 feet below top of ground

(4) Cased to: 73' Size: 2"

(5) Screen: Size: 2" Length: 5'


(6) Were any formations sealed against pollution?

yes, no.

If YES depth of formation: From surface

Why: To prevent surface pollution

Drillers Remarks: Sanitary well seal used.

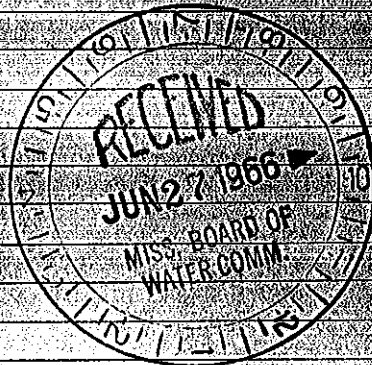

(Use Back Side)

Well No

Mail this copy to Board of Water Commissioners 429 Miss. St. Jackson, Miss.