

Copiah
ETR
6/6/67

MISSISSIPPI
BOARD OF WATER COMMISSIONERS
416 North State Street
Jackson, Mississippi 39201

E11
MSG
CODED

WATER WELL DRILLERS LOG


6-1 1967 *Lynn Central Co.* *Copiah*
date well completed firm name county well located

LANDOWNER <i>TRAVELER GRAVES</i> <i>Company</i> <i>Cryst</i> (mailing address)	description of formations encountered	from	to
		<i>White Clay</i>	<i>6</i>
	<i>Red sandy Clay + Gravel</i>	<i>8</i>	<i>14.5</i>
	<i>SAND + GRAVEL</i>	<i>45</i>	<i>91</i>
	<i>Clay</i>	<i>91</i>	<i>93</i>
	<i>SAND + Pea Gravel</i>	<i>93</i>	<i>111</i>
	<i>Clay</i>	<i>111</i>	<i>118</i>
	<i>SAND</i>	<i>118</i>	<i>121</i>
	<i>HARD CLAY</i>	<i>121</i>	<i>125</i>

WELL LOCATION:
sec *31* T *20* R *1* E
miles *East* of *Crystal*
(distance) (direction) (nearest town)

WELL PURPOSE: *INDUSTRIAL*
(Home, Irrigation, municipal, industrial)

- WELL COMPLETION DATA:
- (1) diameter (inches) *10"*
 - (2) total depth (feet) *143*
 - (3) static water level (feet) *80* below top of ground
 - (4) casing *Steel* *120*
(material) (depth)
10" (size) (if telescopic see back)
 - (5) screen *20"* *120*
(length) (depth to top)
8" *Stainless Steel*
(size) (material)
 - (6) pump *Electric*
(HP) (yield gpm)
(type power)
 - (7) electric log *NO*
(yes or no)
(organization running log)
 - (8) how well bottom plugged *VALVE*

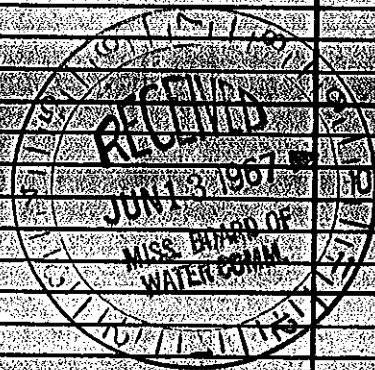

DRILLERS REMARKS:
Customer furnished Pump and Motor
TEST NOT RUN AS OF THIS DATE