

COPIAH MISSISSIPPI BOARD OF WATER COMMISSIONERS

E 28

9-7-65

WATER WELL DRILLERS LOG

CODED

Date: Sept. 7, 1965, Driller: Burney Well Service, Inc County Copiah

(Name)

(1) Owner of land: Pauline Warrington
(Name)

Crystal Springs, Miss.
(Address)

Hopewell Road
(2) Location: 1/4 SE 1/4, Sec 21, T 11 N, R 11 W

4 miles East of Crystal Springs
(distance) (direction)

(3) Topography: Hilly
(Hilly) (Flat) (Level)

(4) Purpose of Well: Domestic
(Domestic, Irrigation, Municipal, Industrial, Other)

Description & Color of Materials Sand, Clay, Red Clay, Shell, etc.	Thick- ness Feet	Depth Feet
Red top soil	8	8
Red sand	18	26
Pea gravel	11	37
Iron rock	4	41
Multicolored clay	7	48
Rock	3	51
Grey & Brown Clay	31	82
Blue clay	13	95
Soft formation	7	102
Fine sand layers	6	108
Rock	1	109
Grey and Brown clay	68	177
Fine sand layers	6	183
Blue shale	81	264
Fine Sand	18	282

Information upon completion of well:

(1) Diameter: 2" inches

(2) Total Depth: 282 feet

(3) Water Level: 198 feet below top of ground

(4) Cased to: 277' Size: 2"

(5) Screen: Size: 25' Length: 5'


(6) Were any formations sealed against pollution?
 yes, no.

If YES depth of formation From surface

Why to prevent surface pollution

Drillers Remarks: well seal used

CODED

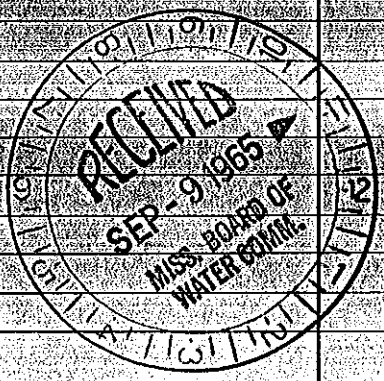

(Use Back Side)

Well No.

Mail this copy to Board of Water Commissioners 429 Miss. St. Jackson, Miss.