

COPIAH MISSISSIPPI BOARD OF WATER COMMISSIONERS

E 29
11-9-65

WATER WELL DRILLERS LOG

[Handwritten signature]

Date: Nov. 9, 1965, Driller: Burney Well Services, Inc. County: Copiah

(Name)

(1) Owner of Land: Clyde Blocker
(Name)

Hwy 27, Crystal Springs, Miss.
(Address)

(2) Location: Hwy 27 East 28 2 1W
1/4 Sec. 2 T. 1 R.
5 miles East of Crystal Springs
(distance) (direction) (town)

(3) Topography: Hilly
(Hilly) (Flat) (Level)

(4) Purpose of Well: Domestic
(Domestic Irrigation Municipal Industrial Other)

Description & Color of Materials Sand, Clay, Red Clay, Shell, etc.	Thick- ness Feet	Depth Feet
Red sand and Gravel	18	18
Red sand	11	29
Water or quick sand	6	35
Pipe clay	15	50
Layers of clay & sand	4	54
Black & Grey clay or Shale	8	62
Blue tight shale	60	122
Fine sand layers	6	128
Shale	5	133
Shale & Fine sand layers	19	152
All fine sand	13	165

Information upon completion of well

(1) Diameter 6 inches.

(2) Total Depth 165 feet.

(3) Water Level 89 feet below top of ground.


(4) Cased to 154' Size 4"

(5) Screen Size 10" Length 10'

(6) Were any formations sealed against pollution?
X yes, no.

15 G.P.M. 3/4 H.P. Sub from 126 ft.

If YES depth of formation From surface
Why to prevent surface pollution
Drillers Remarks: well seal used

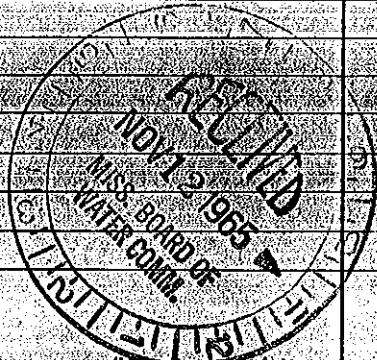

Well No.

all this copy to Board of Water Commissioners 429 Miss. St. Jackson, Miss.