

COPIAH MISSISSIPPI BOARD OF WATER COMMISSIONERS

E 31

1-11-64

WATER WELL DRILLERS LOG

CODED

Date: Jan. 11, 1964, Driller: Burney Water, Copiah County, Copiah

(1) Owner of Land: Baskett R. Turner
(Name)

Routel, Box 435, Crystal Springs

(2) Location: Gatesville River Road
1/4 NW 1/4 Sec. 29, T26N, R14E
2 miles east of Gatesville
(Distance) (Direction) (Nearest Town)

(3) Topography: Flat
(Hilly) (Flat) (Level)

(4) Purpose of Well: Domestic
(Domestic, Irrigation, Municipal, Industrial, Other)

Description & Color of Materials Sand, Clay, Red Clay, Shells, etc.	Thick- ness Feet	Depth Feet
Topsoil	8	8
Buckshot	10	18
Pea gravel & sand	8	26
Blue clay	6	32
Hard black shale	4.0	36
Soft blue clay	8	44
Layers of Sand & Clay	7	51
All sand	3	54
Shale or chalk	1	55

Information upon completion of well:

(1) Diameter: 4 1/2 inches

(2) Total Depth: 111 feet

(3) Water Level: 25 feet below top of ground


(4) Cased to: 111 Size: 2"

(5) Screen: Size: 2 1/2" Length: 5'

(6) Were any formations sealed against pollution?
 yes, no

If YES depth of formation From surface
why to prevent surface pollution

Drillers Remarks:

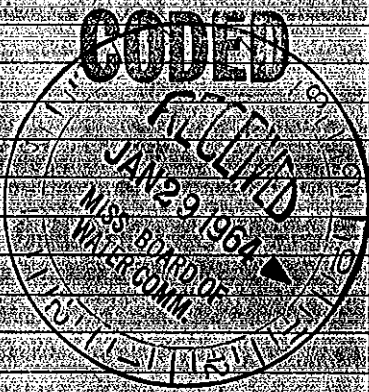

Retain this copy for your office files.

(Use Back Side)

Well No.