

STATE WELL REPORT

Part 1

Driller's Log

Mississippi Department of Environmental Quality
Office of Land and Water Resources
P.O. Box 2309
Jackson, MS 39225-2309
(601)961-5555
(601)961-5228 (fax)

For Office Use Only:

Well #: **E103**
Aquifer: _____
E-Log #: _____

County: Copiah
Permit #: MS-GW-17451
Driller: Butch Bourne
Date drilling completed: 2-20-20

State Law requires that this report be prepared by the license holder responsible for the work and filed with the Department at the above address within 30 days of completion of drilling of the well or borehole.

Well Owner Information <i>(Landowner if borehole is not for a water well)</i>	Well or Borehole Location
Owner Name: <u>Kuhlman Electric Corporation</u>	Latitude: <u>31°57'51.03"N</u> Longitude: <u>90°19'45.67"W</u>
Mailing Address: <u>101 Kuhlman Dr</u>	Method of Lat/Long (check one): Conventional Survey _____, USGS quad _____, Hand-held GPS <input checked="" type="checkbox"/> , Survey-grade GPS _____
<u>Crystal Springs</u> MS <u>39509</u>	<u>SW</u> $\frac{1}{4}$ <u>SW</u> $\frac{1}{4}$, Sec <u>32</u> T <u>2N</u> R <u>1W</u>
City State Zip Code	<u>2.25</u> Miles <u>SE</u> of <u>Crystal Springs</u>
Telephone No. (<u>601</u>) <u>892-4661</u>	(Distance) (Direction) (Nearest Town)

Well / Borehole Data

Date drilling started: 10-18-19 Date drilling completed: 2-20-20 Hole depth: 120' Hole diameter: 21"

Location of the source of any surface water used for drilling: _____

Method of dosing and volume of Chlorine used in drilling and development: _____

Logs run (check all applicable): log run Electric Gamma Ray Density Sonic Neutron Other: _____

Name of organization running log(s): Griner Drilling Service, Inc.

Purpose of borehole (check one): Water Well Geotechnical/Geological Investigation Ground Source Heat Pump Seismic Survey Other (describe) _____

If drilling is not related to water well construction, skip the remainder of this block

Purpose of Well (check all applicable): Home Industrial Public Supply Irrigation Fish Culture

Other (describe): City of Crystal Springs well

If a flowing well, method of flow regulation: Valve _____ Other (describe) _____

Static Water Level: 63.58' feet above or below land surface Date measured: 2-20-20
(check one)

Method of measurement (check one) Steel tape Electric tape Air line Other (describe): _____

Well depth: 120' Well grouted to a depth of: 80 feet Type of grout (check one) Neat Cement Bentonite Mix

Casing length: 80 feet Casing diameter: 16" inches Type of casing: A 53 Grade B

Screen length: 30 feet Screen diameter: 10" inches Type of screen: Robase

Screen slot size: .030 inches Setting depth: From 104' feet to 134' feet

Type of completion (check all applicable) gravel packed Underreamed Open hole Natural Development

Other (describe): _____

Top of lap pipe or reduction in casing: 0' feet

If telescoped or more than one screen, describe on next page

STATE WELL REPORT

Part 2

Pump Installer's Completion Report
 Mississippi Department of Environmental Quality
 Office of Land and Water Resources
 P.O. Box 2309
 Jackson, MS 39225-2309
 (601)961-5210
 (601) 360-0535 (fax)

For Office Use Only:

Well #: E103
 Aquifer: _____

County: Copiah
 Permit #: MS-GW-17451
 Driller: Butch Bourne
 Date completed: 11-20-21
Copy information from block on Part 1

This part of the report must be completed by a licensed water well contractor or a licensed pump installer. A copy of Part 1 of the report must be attached and both parts filed with the Department at the above address within 30 days of well completion.

Well Owner Information	Well Location
Owner Name: <u>Kuhlman Electric</u>	Latitude: <u>31°57'51.03"N</u> Longitude: <u>90°19'45.67"W</u>
Mailing Address: <u>101 Kuhlman Dr.</u>	Method of Lat/Long (check one): Conventional Survey _____, USGS quad _____, Hand-held GPS <input checked="" type="checkbox"/> , Survey-grade GPS _____
Crystal Springs MS 39509	_____ 1/4 _____ 1/4, Sec <u>32</u> T <u>2N</u> R <u>1W</u>
City State Zip Code	<u>2.25</u> Miles <u>SE</u> of <u>Crystal Springs</u>
Telephone No. (<u>601</u>) <u>892-4661</u>	(Distance) (Direction) (Nearest Town)

Pump Type (check one)

Submersible Turbine Air Lift Centrifugal Flowing Well Jet Piston Rotary Other (describe): _____

Date Pump Installed: 11-20-21 Rated Pump Capacity: 250 GPM Gallons Per Minute

Is This Pump (check one): New Repaired Replacement

Power Type (check one)

Electric Diesel Gasoline Natural Gas Tractor PTO Windmill Other (describe): _____

Horse Power Rating of Motor: 20 Setting Depth: 100' feet Number of Stages: 4

Pump Test Data for Non Flowing Well

Date Well Tested: 2-20-20 Duration of Pump Test (minimum 4 hours): 24 hours

Static Water Level (A): 63.58' Feet Below Land Surface Pumping Water Level (B): 94.41 Feet Below Land Surface

Drawdown [(B) - (A)]: 30.83 Feet Below Land Surface Test Pumping Rate: 250 Gallons Per Minute

Method of measurement (check one): Steel tape Electric tape Air line Other (describe): _____

Pump Test Data for Flowing Well

Measured shut in head: _____ feet.

Well yielded _____ GPM with a drawdown of _____ feet after _____ hours of pumping

Meter Installation

Meter Manufacturer: _____ Meter Serial Number: _____

Meter Model Number/Name: _____ Type of Meter: _____

Totalizer Register Unit and Multiplier Factor (AF x .001, gal x 1000, etc): _____

Installation Date: _____ Meter installed by: _____


Is This Meter (check one): New Repaired Replacement

Important: By submitting the above information you are certifying that this meter was installed to manufacturer standards. For agricultural wells, a list of approved meters is on the MDEQ website.

I HEREBY CERTIFY that the above statements are true to the best of my knowledge.

Charles Griner 0-184 11-20-21 Charles H. Griner

Print Name of Pump Installer and License No. (if applicable) Date Signature of Pump Installer

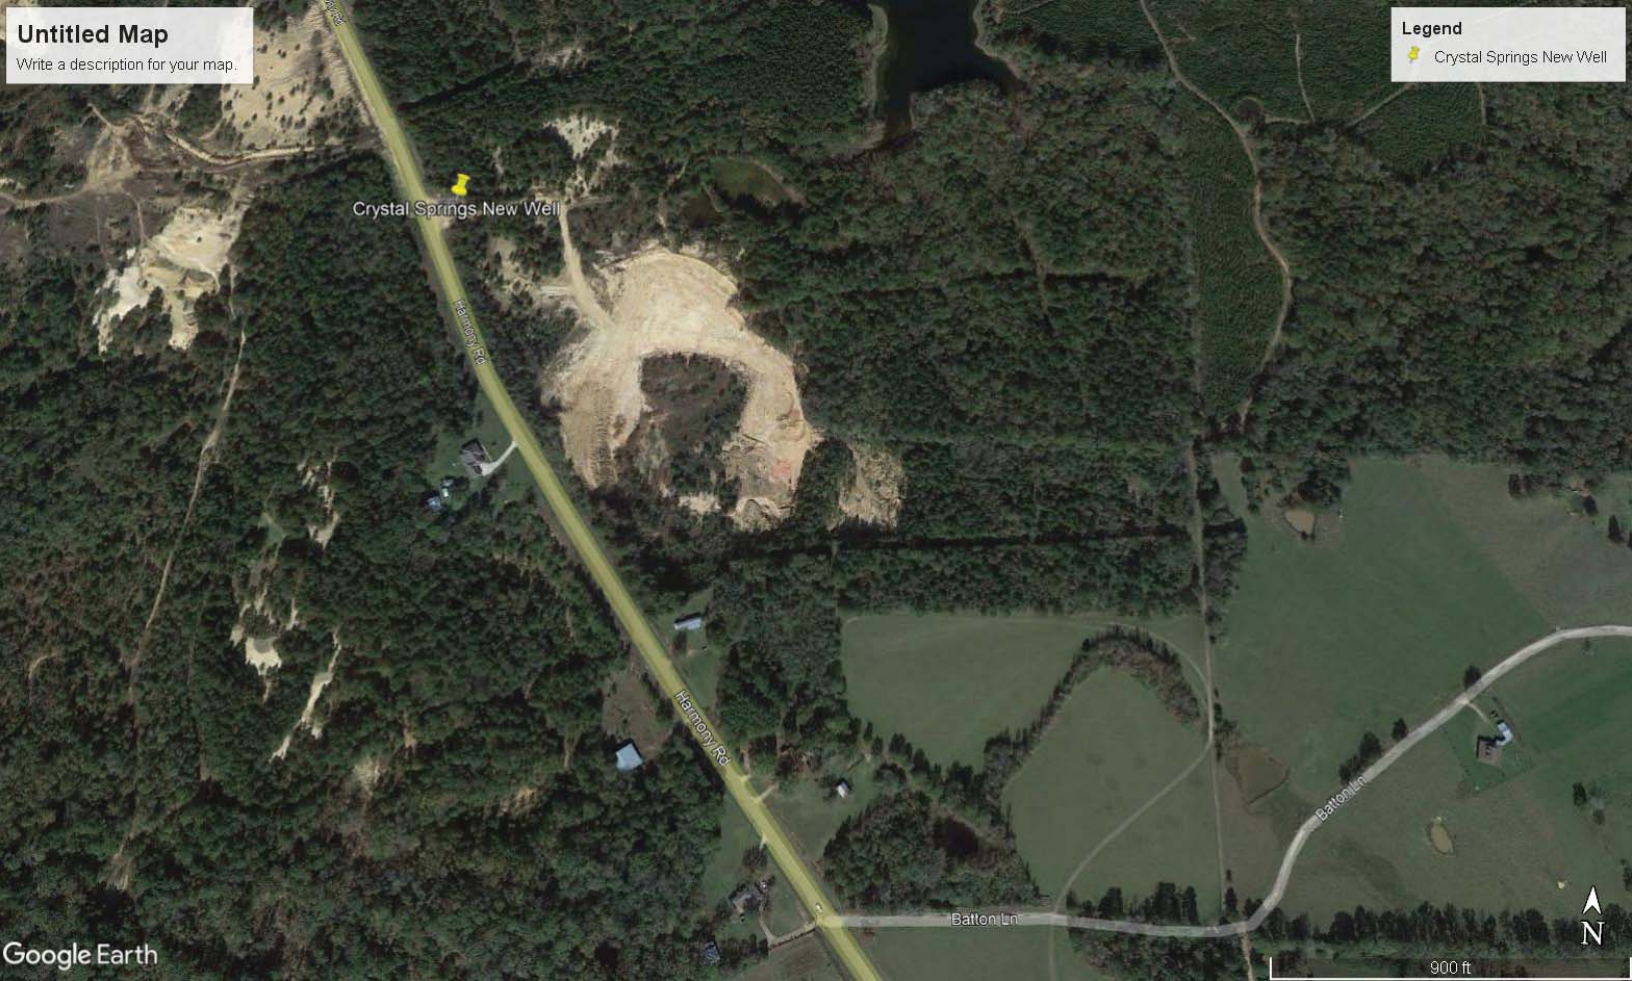

Untitled Map
Write a description for your map.

Legend
Crystal Springs New Well

Crystal Springs New Well

Harmony Rd

Harmony Rd

Baton Ln

Baton Ln

Google Earth

900 ft

