

COPIAH MISSISSIPPI BOARD OF WATER COMMISSIONERS


E 2003

6-27-61

WATER WELL DRILLERS LOG

Date: June 27, 1961, Driller: Burney Water Well Serv. County: Copiah

(Name)		Description & Color of Materials Sand, Clay, Red Clay, Shell, etc.	Thickness Feet	Depth Feet
(1) Owner of land: <u>John Sykes, Sr.</u> (Name)		<u>Topsoil & clay</u>	<u>11</u>	<u>11</u>
<u>Crystal Springs, Miss.</u> (Address)		<u>Sand & gravel</u>	<u>57</u>	<u>68</u>
(2) Location: <u>6 Mile Road</u> (distance) (direction) (Nearest Town)		<u>Quick sand</u>	<u>22</u>	<u>90</u>
<u>1/2 Sec. 21 W</u>		<u>Water strata</u>	<u>16</u>	<u>106</u>
<u>3 miles East of Crystal Spgs.</u>				
(3) Topography: <u>Hilly</u> (Hilly) (Flat) (Level)				
(4) Purpose of Well: <u>Domestic</u> (Domestic, Irrigation, Municipal, Industrial, Other)				
Information upon completion of well:				
(1) Diameter: <u>4</u> inches				
(2) Total Depth: <u>106</u> feet				
(3) Water Level: <u>52</u> feet below top of ground				
(4) Cased to: <u>97 1/2'</u> Size: <u>2"</u>				
(5) Screen: Size: <u>2"</u> Length: <u>5'</u>				
(6) Were any formations sealed against pollution? <u>X</u> yes, <u> </u> no.				
If YES depth of formation: <u>From surface</u>				
Why: <u>To prevent surface pollution</u>				
Drillers Remarks:				
				Well No.

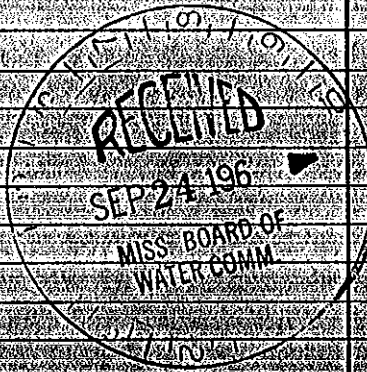

(Use Back Side)

Mail this copy to Board of Water Commissioners 429 Miss. St. Jackson, Miss.