

COPIAH MISSISSIPPI BOARD OF WATER COMMISSIONERS

E 2004  
7-20-61

WATER WELL DRILLERS LOG

Date JULY 20, 1961, Driller BEN BRIDGES, 426 S. Main, County COPIAH

(1) Owner of Land M. J. Taylor, Vidalia, (Name)  
Highway Road, Vidalia, (Address)  
Crystal Springs, Miss. (City)  
 (2) Location V 10 2 YW  
7 1/2 miles East of Crystal Springs, (Distance) (direction)  
 (3) Topography Rolling  
 (Hilly) (Flat) (Level)  
 (4) Purpose of Well Domestic  
 (Domestic, Irrigation, Municipal, Industrial, Other)

Description of Material Sand, Clay, Red Clay, Shell, etc.	Thick- ness Feet	Depth Feet
Top soil & red clay	5	5
Red clay & sand	20	25
Thin clay, sand, layers	25	70
Red clay gravel	28	108
Clay & sand in layers	20	128
Thin outer sand	26	154
Water Strata	16	180

Information upon completion of well

(1) Diameter 4 inches

(2) Total Depth 182 feet

(3) Water Level 126 feet below top of ground

(4) Cased to 170 feet


(5) Screen Size 2 inches length 10 ft

(6) Were any formations sealed against pollution?  
 Yes yes / No no

If YES depth of formation From surface

Why sealed against pollution?  
to prevent pollution

Drillers Remarks: Well completely  
sanitized with Perchlorine

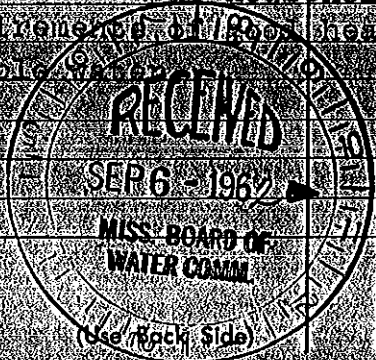

Well No

Mail this copy to Board of Water Commissioners 429 Miss. St. Jackson, Miss.