

COPIAH MISSISSIPPI BOARD OF WATER COMMISSIONERS


2008
3-20-62

WATER WELL DRILLERS LOG

Date: Mar. 20, 19 62 Driller: Burney Water Well Service Copiah

(Name)

(1) Owner of Land: <u>E. F. Barlow</u> (Name)	Description & Color of Materials Sand, Clay, Red Clay, Shell, etc.	Thickness Feet	Depth Feet
<u>Crystal Springs, Miss.</u> (Address)	<u>Red clay</u>	<u>10</u>	<u>10</u>
<u>Harmony Road</u>	<u>Gravel & sand</u>	<u>102</u>	<u>112</u>
(2) Location: <u>1/4 Sec. 30 2 1W</u>	<u>Pipe clay</u>	<u>8</u>	<u>120</u>
<u>7 miles East of Crystal Springs</u> (distance) (direction) (Nearest Town)	<u>Sand & clay layers</u>	<u>10</u>	<u>130</u>
(3) Topography: <u>Hilly</u> (Hilly) (Flat) (Level)	<u>Pea gravel</u>	<u>6</u>	<u>136</u>
(4) Purpose of Well: <u>Domestic</u> (Domestic, Irrigation, Municipal, Industrial, Other)	<u>Layers clay with dk. sand</u>	<u>41</u>	<u>177</u>
Information upon completion of well:	<u>Pea gravel & open</u>	<u>3</u>	<u>180</u>
(1) Diameter: <u>4</u> inches			
(2) Total Depth: <u>180</u> feet			
(3) Water Level: <u>151</u> feet below top of ground			
(4) Casing No: <u>1541</u> Size: <u>2"</u>			
(5) Screen Size: <u>2"</u> Length: <u>5'</u>			
(6) Were any formations sealed against pollution? <u>X</u> yes, <u>no</u>			
If YES depth of formation: <u>From surface</u>			
Why: <u>To prevent surface pollution</u>			
Drillers Remarks:			

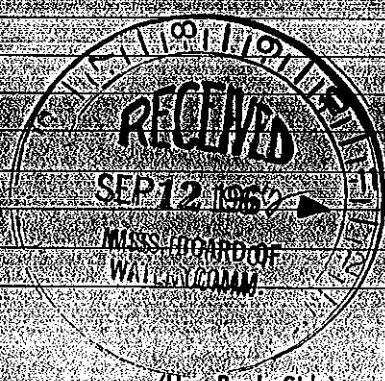

(Use Back Side)

Well No.

Mail this copy to Board of Water Commissioners 429 Miss. St. Jackson, Miss