


COPIAH MISSISSIPPI BOARD OF WATER COMMISSIONERS

2013 WATER WELL DRILLERS LOG
11-1-62

Date: Nov. 1, 1962 Driller: Eubank, Walter (Civil Service) County: Copiah

(1) Owner of Land	Description & Color of Material	Thickness Feet	Depth Feet
U. T. Sharpe (Name)	Red topsoil	6	6
Old Highway 51 (Address)	Red sand & clay	12	18
(2) Location: 2 1/4 miles North of Baysal Springs (direction) (Near town)	White sand	8	26
(3) Topography: Hilly (Hilly) (Flat) (Level)	Sandstone	3	29
(4) Purpose of Well: Domestic (Domestic Irrigation Municipal Industrial Other)	Grey shale & limestone	13	42
Information upon completion of well:	Layers white sand	8	50
(1) Diameter: 4 inches	Blue clay & shale	20	70
(2) Total Depth: 306 feet	Hard shale & marl	25	95
(3) Water Level: 85 feet below top of ground	Layers fine sand	15	110
(4) Cased to: 181 feet Size: 2"	Hard clay & shale	20	130
(5) Screen: Size: 2" Length: 5'	Fine sand layers	6	136
(6) Were any formations sealed against pollution? <input checked="" type="checkbox"/> yes <input type="checkbox"/> no	Hard clay & shale	12	148
If YES depth of formation: From Surface	Soft brown formation	9	157
Why to prevent surface pollution:	Hard blue clay	18	175
Drillers Remarks:	Layers fine sand	6	181
	Limestone	5	186
	Hard rock formation	2	188
	Layers clay, sand & shale	118	306

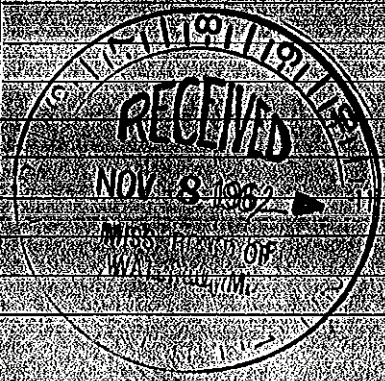

(Use Back Side)

Well No.

Mail this copy to Board of Water Commissioners, 429 Miss. St. Jackson, Miss.