

COPIAH MISSISSIPPI BOARD OF WATER COMMISSIONERS
E 2016
8-21-63
WATER WELL DRILLERS LOG


Date: 8-21-63 1963 Driller: Ben Burney County Copiah
(Name)

(1) Owner of land: Harley Gordon
(Name)
Rt. 1, Crystal Springs, Miss.
(Address)
Didlake Road
 (2) Location: 1/4 Sec. 2 T. 100 R.
2 miles N 23 of Crystal Springs
(distance) (direction) (nearest town)
 (3) Topography: Hilly
(Hilly) (Flat) (Level)
 (4) Purpose of Well: Domestic
(Domestic; Irrigation; Municipal; Industrial; Other)

Description & Color of Material <small>(Sand, Clay, Red Clay, Shell, etc.)</small>	Thickness <small>(Feet)</small>	Depth <small>(Feet)</small>
RED TOP SOIL	7	7
SAND & PEA GRAVEL	7	14
PIPER CLAY	3	22
SAND	18	40
ROCK	1	41
GREY CLAY	7	48
ROCK	4	52
BLUE CLAY	40	92
MED. SAND	8	100
ROCK	1	101
BLACK SHALE	1	102

Information upon completion of well:

(1) Diameter 4 inches.
 (2) Total Depth 102 feet.
 (3) Water Level 52 feet below top of ground.
 (4) Cased to 96 Size 2"
 (5) Screen Size 24" Length 5'
 (6) Were any formations sealed against pollution?
 Yes, no

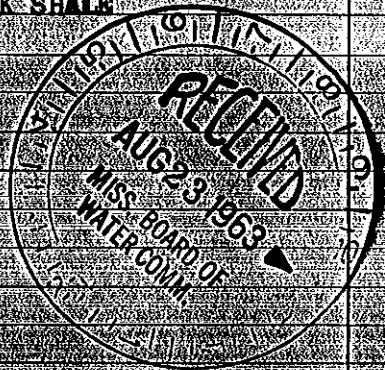

If YES depth of formation From surface

Why to prevent surface pollution

Drillers Remarks

Well No.

(Use Back Side)

Mail this copy to Board of Water Commissioners 429 Miss. St. Jackson, Miss