

COPIAH MISSISSIPPI BOARD OF WATER COMMISSIONERS

E 202
4-14-65

WATER WELL DRILLERS LOG

Date Apr 14 1965 Driller Burney Water Well Serv. County Copiah

(1) Owner of Land: W. A. Barnes
(Name)

Route 1 Crystal Springs, Miss.
(Address)

Barnes Road
(2) Location: 1/4 1/4 1/4 Sec. 12 1W
(distance) (direction) (Nearest Town)

6 miles east of Crystal Springs
(distance) (direction) (Nearest Town)

(3) Topography: Hilly
(Hilly) (Flat) (Level)

(4) Purpose of Well: Domestic
(Domestic, Irrigation, Municipal, Industrial, Other)

Description & Color of Materials Sand, Clay, Red Clay, Shell, etc.	Thick- ness Feet	Depth Feet
Topsoil & pipe clay	15	15
Hard formation	7	22
Grey & blue clay	14	36
Blue clay	6	42
Brown & Blue Formation	6	48
Blue clay	23	71
Blue sand	6	77
Clay layers	3	80
Sand best (water)	7	87
Blue shale	3	90

Information upon completion of well:

(1) Diameter 4 inches.

(2) Total Depth 90 feet.

(3) Water Level 56 feet below top of ground.


(4) Cased to 8 1/2' Size 2"

(5) Screen Size 2 1/2" Length 5'

(6) Were any formations sealed against pollution?
X yes, no

If YES depth of formation From surface
Why to prevent surface pollution

Drillers Remarks:

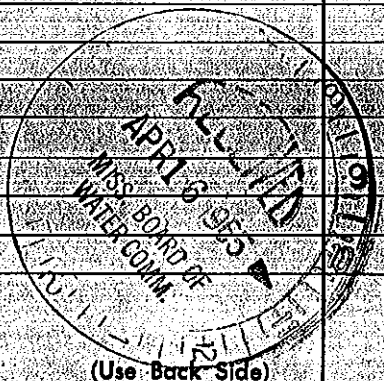

Well No.

Mail this copy to Board of Water Commissioners 429 Miss. St. Jackson, Miss.