

COPIAH MISSISSIPPI BOARD OF WATER COMMISSIONERS

E 2024
9-8-65

WATER WELL DRILLERS LOG


Date: Sept 8, 1965 Driller: Birney Well Service, Inc County: Copiah
(Name)

(1) Owner of Land:	Description & Color of Materials Sand, Clay, Red Clay, Shell, etc.	Thickness Feet	Depth Feet
<u>Gus Patton, Jr.</u> (Name)	<u>Top soil and clay</u>	<u>12</u>	<u>12</u>
<u>362 Beverly Cir. Crystal Springs</u> (Address)	<u>Red sand</u>	<u>13</u>	<u>25</u>
<u>Harmony Road</u> (2) Location: <u>32</u> Miss. <u>21</u> W	<u>Pea gravel and sand</u>	<u>21</u>	<u>46</u>
<u>1/4 Sec</u>	<u>Big sand gravel</u>	<u>24</u>	<u>70</u>
<u>6 miles East</u> of <u>Crystal Springs</u> (distance) (direction) (Location)	<u>Pipe clay</u>	<u>8</u>	<u>78</u>
(3) Topography: <u>Hilly</u> (Hilly) (Flat) (Level)	<u>Water sand</u>	<u>18</u>	<u>96</u>
(4) Purpose of Well: <u>Domestic</u> (Domestic Irrigation, Municipal, Industrial, Other)	<u>Coarse best sand</u>	<u>9</u>	<u>105</u>
	<u>Rock</u>	<u>1/2</u>	<u>105 1/2</u>

Information upon completion of well:

- (1) Diameter: 4 inches
- (2) Total Depth: 105 1/2 feet
- (3) Water Level: 54 feet below top of ground
- (4) Cased to: 97' Size: 4"
- (5) Screen: Size: 4" Length: 7'
- (6) Were any formations sealed against pollution?
 yes no

If YES depth of formation from surface _____
Why cement grout 20' below surface to prevent surface pollution
Drillers Remarks: well seal used

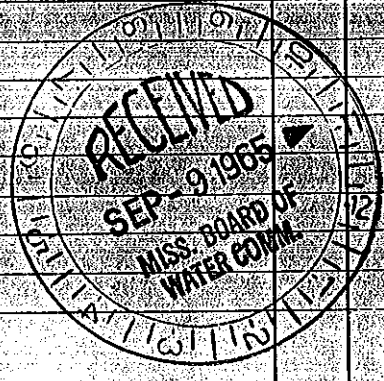

(Use Back Side)

Well No

Mail this copy to Board of Water Commissioners 429 Miss. St. Jackson, Miss.