

COPIAH MISSISSIPPI BOARD OF WATER COMMISSIONERS

E 2025  
9-14-65

WATER WELL DRILLERS LOG

Date: Sept. 14, 1965 Driller: Burney Well Service, Inc. County: Copiah

(Name)

(1) Owner of Land: Corles Walls, Jr.  
(Name)  
Johnson Road, Crystal Springs,  
(Address)  
Johnson Road Miss.  
(2) Location: 1/4 Sec. 7 T. 12 N.  
5 miles East of Crystal  
(distance) (direction) (town)  
(3) Topography: Hilly  
(Hilly) (Flat) (Level)  
(4) Purpose of Well: Domestic  
(Domestic, Irrigation, Municipal, Industrial, Other)

Description & Color of Materials Sand, Clay, Red Clay, Shell, etc.	Thickness Feet	Depth Feet
Red top soil	6	6
Pipe clay	6	12
Rock or Limestone	11	23
Hard brown clay	7	30
Blue clay	10	40
Hard Grey Shale	21	61
Soft Blue Clay	3	64
Hard Grey Shale	14	78
Blue Clay	14	92
Limestone	10	102
Fine sand layers	8	110
Clay & Short layers of fine sand	58	168
Fine sand	15	183
Rock	1	184
Fine sand in layers	26	210
Hard shale	28	238
Sand	2	240
Limbo	10	250
Fine sand	16	266
All fine sand	20	286
Hard Shale	2	288

Information upon completion of well:

(1) Diameter: 4 inches

(2) Total Depth: 288 feet

(3) Water Level: 100 feet below top of ground

(4) Cased to: 268' Size: 2"


(5) Screen: Size: 2 1/2" Length: 10'

(6) Were any formations sealed against pollution?  
X yes, no

If YES depth of formation from surface \_\_\_\_\_

Why to prevent surface pollution \_\_\_\_\_

Drillers Remarks: well head used

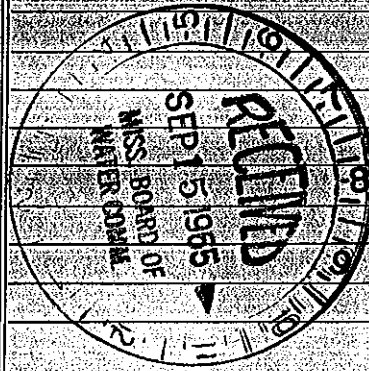

(Use Back Side)

Well No.

Send this copy to Board of Water Commissioners 429 Miss. St. Jackson, Miss.