

COPIA

MISSISSIPPI BOARD OF WATER COMMISSIONERS

E 2026
3-2-66

WATER WELL DRILLERS LOG

Date: 3/2/66 Driller: Forest Drilling Co. Copiah
(Name)

(1) Owner of Land: J. M. Cook
(Name)
Rt 1 Copiah Springs

(2) Location: 2.3 mi. S.W. of Copiah
6 miles East of Copiah
(distance) (direction) (nearest town)

(3) Topography: Hilly Flat Level

(4) Purpose of Well: Home
(Domestic, Irrigation, Municipal, Industrial, Other)

Description & Color of Materials Sand, Clay, Red Clay, Shell, etc.	Thick- ness Feet	Depth Feet
Sand, Clay & Gravel		21
Rock		32
Chalky Clay & Sand		67
Hard Blue Clay		87
Clay & Silt & Sulf		95
Blue Silt & Silt & Sulf		123
Hard Shale		205
Clay		212
Fine Sand		224

Information upon completion of well:

(1) Diameter: 2 inches

(2) Total Depth: 224 feet

(3) Water Level: 160 feet below top of ground

(4) Cased to: 214 Size: 2"


(5) Screen: Size: 2" Length: 10ft

(6) Were any formations sealed against pollution?
yes no

If YES depth of formation:

Why:

Drillers Remarks:

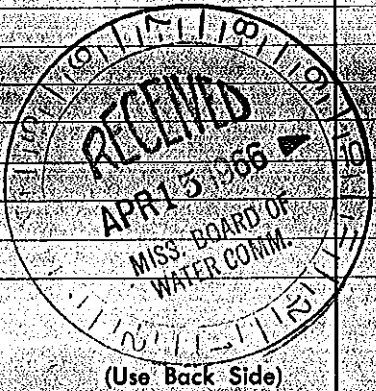

Well No