

COPIA  
B G 4  
8-18-60

MISSISSIPPI BOARD OF WATER COMMISSIONERS

MJS  
24

WATER WELL DRILLERS LOG

Date: Aug 18, 1960, Driller: Burney Water Well Serv. County: Copiah  
(Ben Burney & Son)

(1) Owner of Land: R. W. Mohon  
(Name)  
Carpenter, Miss.  
(Address)  
Dentville

(2) Location: SE 1/4 NE 1/4 Sec. 1 T. N4W  
7 miles East of Carpenter  
(distance) (direction) (Nearest Town)

(3) Topography: Hilly  
(Hilly) (Flat) (Level)

(4) Purpose of Well: Domestic  
(Domestic Irrigation) (Municipal) (Industrial) (Other)

Description & Color of Materials Sand, Clay, Red Clay, Shell, etc.	Thick- ness Feet	Depth Feet
Red topsoil	30	30
Sand & gravel	6	36
Hard blue clay	16	52
Layers sand & clay	10	62
Layers sand	22	84
Sand	18	102

Information upon completion of well:

(1) Diameter: 4 inches

(2) Total Depth: 102 feet

(3) Water Level: 63 feet below top of ground


(4) Cased to: 94 ft / Size: 2"

(5) Screen: Size: 2" / Length: 5 ft

(6) Were any formations sealed against pollution?  
 yes,  no

Elev 265' Topo

**CODED**

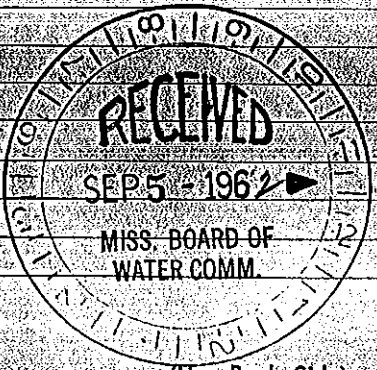

Well No.