

G9

Copiah
G
1-67

MISSISSIPPI
BOARD OF WATER COMMISSIONERS
416 North State Street
Jackson, Mississippi 39201
WATER WELL DRILLERS LOG

CODED

1-13 1967 EB FORE Copiah
date well completed firm name county well located


LANDOWNER Edwin E Hood
Carpenter Missis
(mailing address)

description of formations encountered	from	to
Brown Red cl	0	20
Silt & Sh. cl	20	36
cl	30	31
White cl	31	33
Blue cl	33	40
White Sh. cl + sd	40	50
cl	50	60
White Sh	60	70
Silt Sh. cl	70	80
cl	80	90
Sh	90	100
cl	100	110
cl	110	120
cl	120	130
cl	130	133
cl	133	140

WELL LOCATION: NE NW
sec. 1 T 11 N R 4 W
10 miles E Carpenter
(distance) (direction) (nearest town)

WELL PURPOSE: Home
(home, irrigation, municipal, industrial)

- WELL COMPLETION DATA:
- (1) diameter (inches) 4"
 - (2) total depth (feet) 140
 - (3) static water level (feet) 67 below top of ground.
 - (4) casing (material) Galv 124' (depth)
 - (5) screen (size) 2" (length) 6' (depth to top) Brass & Galv
 - (6) pump (HP) 3/4 (yield gpm) 6 ELEC
 - (7) electric log (yes or no) NO
 - (8) how well bottom plugged

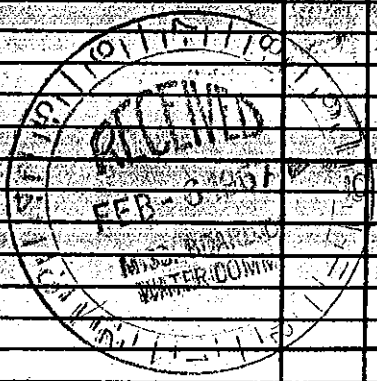

DRILLERS REMARKS: