

COPIA  
 6 X 11  
 5-15-63

MISSISSIPPI BOARD OF WATER COMMISSIONERS

COPIA

WATER WELL DRILLERS LOG

M.P.S.  
 8/11  
 CODED

Date: May 15, 1963 Driller: Ed Jew County: Jackson  
 (Name)


(1) Owner of Land: Katherine Dee  
 (Name)  
Carpenter Miss  
 (Address)  
 (2) Location: NE 1/4, NE 1/4, Sec 3, T11N, R4E  
16 miles W of Hazlehurst  
 (distance) (direction) (Nearest Town)  
 (3) Topography: Hilly  
 (Hilly) (Flat) (Level)  
 (4) Purpose of Well: Domestic  
 (Domestic Irrigation, Municipal, Industrial, Other)

Description & Color of Materials Sand, Clay, Red Clay, Shell, etc.	Thick- ness Feet	Depth Feet
Brown Clay	0	10
Brown Clay	10	15
Brown Sand	15	20
-	20	30
-	30	40
Blue Clay	40	56
Blue clay & Sl streaks	56	65
Blue Sand	65	128

Information upon completion of well:

(1) Diameter 6" inches.  
 (2) Total Depth 128' feet.  
 (3) Water Level 25' feet below top of ground.  
 (4) Cased to 128', Size 4"  
 (5) Screen: Size 20 Length 5'  
 (6) Were any formations sealed against pollution?  
 \_\_\_\_\_ yes, \_\_\_\_\_ no.

If YES depth of formation \_\_\_\_\_  
 Why \_\_\_\_\_  
 Drillers Remarks: \_\_\_\_\_

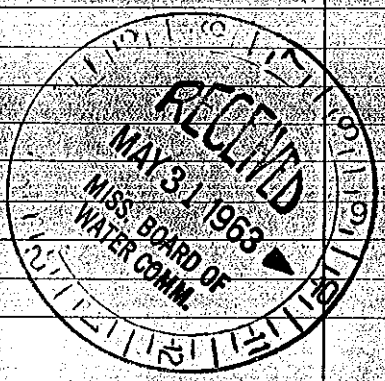

(Use Back Side)

Well No.

Mail this copy to Board of Water Commissioners 429 Miss. St. Jackson, Miss.