

COPIAH MISSISSIPPI BOARD OF WATER COMMISSIONERS

G N 12
3-27-63

WATER WELL DRILLERS LOG

M 88
912

Date: March 27, 1963, Driller: Burney Water Well Serv. County Copiah

(Name)

(1) Owner of Land: Harold Hood
(Name)
Route 1, Carpenter, Miss.
(Address)
Carpenter, Dentville Road
(2) Location: NE 1/4, NE 1/4, Sec. 3, T12N, R4W
2 1/2 miles West of Dentville
(distance) (direction) (Nearest Town)

(3) Topography: Hilly
(Hilly) (Flat) (Level)

(4) Purpose of Well: Domestic
(Domestic, Irrigation, Municipal, Industrial, Other)

Description & Color of Materials Sand, Clay, Red Clay, Shell, etc.	Thick- ness Feet	Depth Feet
Red clay & sand	26	26
Blue clay	70	96
Fine sand layers	26	120
All sand but fine	16	136
Med size good sand	20	156

Elev 342' Topo

Information upon completion of well:

(1) Diameter 4 inches.

(2) Total Depth 156 feet.

(3) Water Level 30 feet below top of ground.

(4) Cased to 156' Size 2"


(5) Screen: Size 2 1/2" Length 5'

(6) Were any formations sealed against pollution?
 yes, no.

If YES depth of formation from surface

Why to prevent surface pollution

Drillers Remarks:

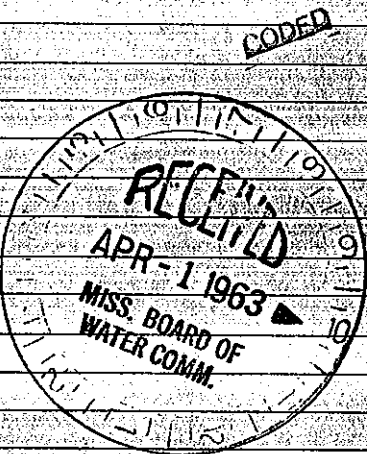

(Use Back Side)

Well No.

Mail this copy to Board of Water Commissioners 429 Miss. St. Jackson, Miss.