

COPIAH MISSISSIPPI BOARD OF WATER COMMISSIONERS

613
3-8-65

WATER WELL DRILLERS LOG

CODED


Date: March 8, 1965, Driller: Burney Water Well Service County: Copiah
(Name)

	Description & Color of Materials Sand, Clay, Red Clay, Shell, etc.	Thick- ness Feet	Depth Feet
(1) Owner of Land: <u>W. C. Deviney</u> (Name)	Red sand	26	26
<u>Box 6717, Jackson, Miss.</u> (Address)	Grey clay	8	34
(2) Location: <u>7</u> <u>1/4</u> , <u>NW</u> , Sec <u>7</u> , <u>T18R4W</u>	Blue clay	26	60
<u>7</u> miles <u>SE</u> of <u>Carpenter</u> (distance) (direction) (Nearest Town)	Limestone	12	72
(3) Topography: <u>Hilly</u> (Hilly) (Flat) (Level)	Blue clay	30	102
(4) Purpose of Well: <u>Domestic</u> (Domestic Irrigation, Municipal, Industrial, Other)	Fine sand yellow	78	180
	Shale layers in sand	20	200
	Fine sand	30	230
	Shale	8	238
	Sand	28	266

Information upon completion of well:

- (1) Diameter 6 inches.
- (2) Total Depth 266 feet.
- (3) Water Level 101 feet below top of ground.
- (4) Cased to 251', Size 4" to 177', 2" to 251'
- (5) Screen: Size 2 1/2", Length 15'
- (6) Were any formations sealed against pollution?
X yes, no.

If YES depth of formation: From surface
Why: Sanitary well seal to prevent surface pollution
Drillers Remarks:

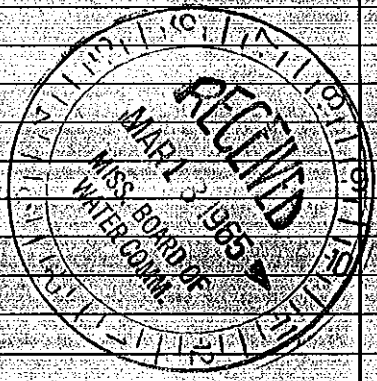

(Use Back Side)

Well No.