

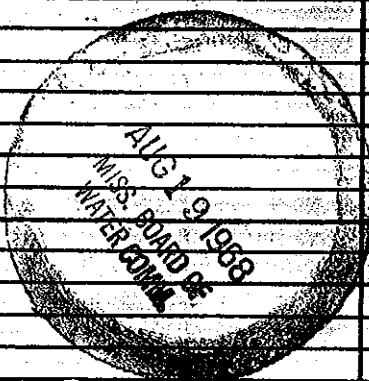
Copiah
H 3
8-68

MISSISSIPPI
BOARD OF WATER COMMISSIONERS
416 North State Street
Jackson, Mississippi 39201

CODED

WATER WELL DRILLERS LOG

August 5 1968 Burney Water Well Service, Inc. Copiah
date well completed firm name county well located

LANDOWNER: <u>Jimmy Anderson</u>	description of fomations encountered	from	to
<u>Route 3, Box 109-A</u>			
<u>Crysta l Springs, Miss.</u> (mailing address)	Red top soil	0	4
WELL LOCATION: sec <u>5</u> T <u>11</u> N R <u>3</u> E <u>1</u> miles <u>W</u> of <u>Dentville</u> (distance) (direction) (nearest town)	Red & grey pipe clay	4	15
	grey sandy formation	15	21
	White med. sand	21	35
	rock	35	36
	grey clay	36	38
	Blue clay	38	41
	rock	41	42
	Blue shale	42	64
	grey shale	64	80
	red & blue clay	80	93
fine sand layers	93	102	
Tight blue clay	102	152	
all very fine sand	152	190	
shale	190	193	
WELL PURPOSE: <u>Home</u> (home, irrigation, municipal, industrial)			
WELL COMPLETION DATA:			
(1) diameter (inches) <u>4 1/2"</u>			
(2) total depth (feet) <u>193'</u>			
(3) static water level (feet) <u>61'</u> below top of ground. XXXXX			
(4) casing <u>Galv.</u> <u>172'</u> (material) (depth) <u> </u> If telescope see back. (size)			
(5) screen <u>5'</u> <u>172'</u> (length) (depth to top) <u>2 1/2"</u> <u>No. 7 SS. Screen</u> (size) (material)			
(6) pump <u>3/4</u> <u>900 GPH</u> (HP) (yield gpm) <u>electric</u> (type power)			
(7) electric log <u>no</u> (yes or no) 6.5% 3.0%			
(8) how well bottom plugged <u>Backwash valve used</u>			
DRILLERS REMARKS:			
			
291			