

COPIA

MISSISSIPPI BOARD OF WATER COMMISSIONERS

8-28-62 WATER WELL DRILLERS LOG

Date: Aug. 28, 1962, Driller: Burney Water Well Serv. County Copiah

(Name)

(1) Owner of Land: Mrs. Linnie Crisco

(Name)

Hazlehurst, Miss.

(Address)

(2) Location: Dentville, Sec 13W

miles of Dentville

(distance) (direction) (Nearest Town)

(3) Topography: Hilly

(Hilly) (Flat) (Level)

(4) Purpose of Well: Domestic

(Domestic, Irrigation, Municipal, Industrial, Other)

Information upon completion of well:

(1) Diameter 4 inches

(2) Total Depth 100 feet

(3) Water Level 53 feet below top of ground

(4) Cased to 92 1/2' Size 2"

(5) Screen Size 2 1/2" length 5'

(6) Were any formations sealed against pollution?


X yes no

If YES depth of formation from surface

Why To prevent surface pollution

Drillers Remarks

Description & Color of Materials Sand, Clay, Red Clay, Shell, etc.	Thick- ness Feet	Depth Feet
Topsoil & clay	10	10
Sand	2	12
Pipe clay	14	26
Sand & fine gravel	9	35
Big gravel	5	40
Layers sand & clay	42	82
Fine sand	13	95
Med sand	5	100

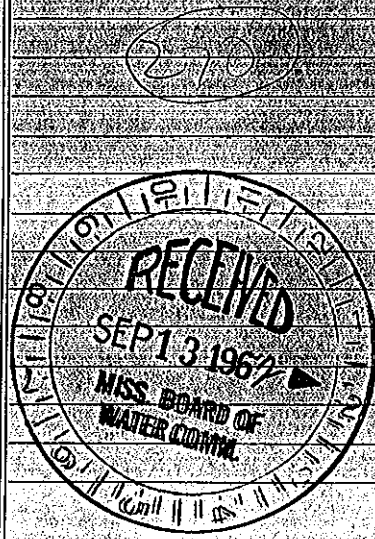

(Use Back Side)

Well No

Mail this copy to Board of Water Commissioners 429 Miss. St. Jackson, Miss