

COPIAH

MISSISSIPPI BOARD OF WATER COMMISSIONERS

J
8-14-62

WATER WELL DRILLERS LOG

Date: Aug 14 1962 Driller: Burney Water Well Serv County: Copiah

(1) Owner of Land: L. B. Trawick
(Name)
Gallman, Miss.

(2) Location: Country T. 1 R. 3
miles 1 1/2 of S. 130 N. 10 W.
(distance) (direction) (Nearest Town)

(3) Topography: Hilly
(Hilly) (Flat) (Level)

(4) Purpose of Well: Domestic
(Domestic) (Irrigation) (Municipal) (Industrial) (Other)

Description & Color of Materials Sand, Clay, Red Clay, Shell, etc.	Thick- ness Feet	Depth Feet
Topsoil & clay	16	16
Sand & gravel	24	40
Clay, sand, gravel	25	65
Water strata	4	69
Sand, gravel & clay	71	140
Sandstone & rock	2	142
Loose sand	6	148
Pipe clay	2	150

Information upon completion of well:

(1) Diameter: 4 inches


(2) Total Depth: 150 feet

(3) Water Level: 100 feet below top of ground

(4) Cased to: 1 1/3' Size: 2"

(5) Screen: Size: 25" Length: 5'

(6) Were any formations sealed against pollution?
 yes, no.

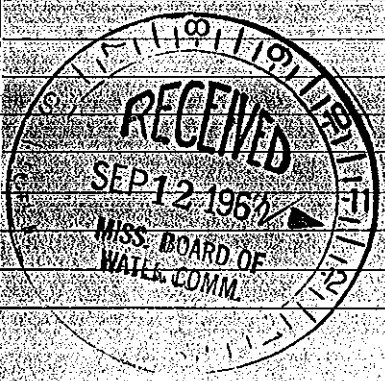

If YES, depth of formation from surface From surface

Why To prevent surface pollution

Drillers Remarks:

Well No.

(Use Back Side)

Mail this copy to Board of Water Commissioners 429 Miss. St. Jackson, Miss.