

COPIAH MISSISSIPPI BOARD OF WATER COMMISSIONERS

4-26-65

WATER WELL DRILLERS LOG

Date: April 26, 1965, Driller: Burney Water Well Serv. County Copiah

(Name)

(1) Owner of Land: Garland M. Brooking
(Name)

Route 3, Hazlehurst, Miss.

(Address)

(2) Location: Lilly Road 26 1 20
1/4, 1/4, Sec. T. R.

7 miles south east of Crystal Springs
(distance) (direction) (Nearest Town)

(3) Topography: hilly
(Hilly) (Flat) (Level)

(4) Purpose of Well: Domestic
(Domestic, Irrigation, Municipal, Industrial, Other)

Description & Color of Materials Sand, Clay, Red Clay, Shell, etc.	Thick-ness Feet	Depth Feet
<u>Topsoil & clay</u>	<u>8</u>	<u>8</u>
<u>Red sand</u>	<u>37</u>	<u>45</u>
<u>Pea gravel & sand</u>	<u>45</u>	<u>90</u>
<u>Pea gravel & pipe clay</u>	<u>19</u>	<u>109</u>
<u>Sand & clay layers</u>	<u>13</u>	<u>122</u>
<u>Pea gravel, clay & sand</u>	<u>28</u>	<u>150</u>
<u>Clay & pea gravel</u>	<u>9</u>	<u>159</u>
<u>Rock</u>	<u>2</u>	<u>161</u>
<u>Grey clay</u>	<u>9</u>	<u>170</u>
<u>Sand & clay</u>	<u>12</u>	<u>182</u>
<u>All sand</u>	<u>31</u>	<u>213</u>
<u>Rock</u>	<u>1</u>	<u>214</u>

Information upon completion of well:

(1) Diameter: 6 inches.

(2) Total Depth: 214 feet.

(3) Water Level: 53 feet below top of ground.

(4) Cased to: 204', Size: 4"

(5) Screen: Size 2 1/2", Length: 10'


(6) Were any formations sealed against pollution?

X yes, no.

If YES depth of formation From surface

Why to prevent surface pollution

Drillers Remarks: used sanitary well seal

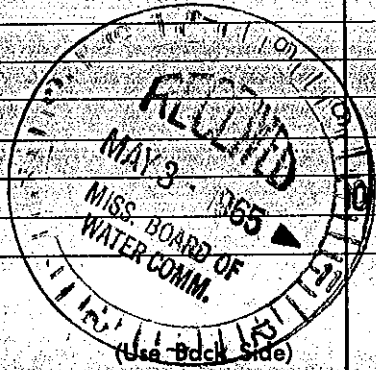

Well No.

(Use Back Side)

Mail this copy to Board of Water Commissioners 429 Miss. St. Jackson, Miss.