

Copiah  
T 38  
11-66


MISSISSIPPI BOARD OF WATER COMMISSIONERS

WATER WELL DRILLERS LOG

**CODED**

Date: November 9, 1966, Driller: Burney Water Well Service County: Copiah  
(When well drilled) (Name) (Where well is located)

(1) Owner of Land: <u>Howard Owens</u> <small>(Name)</small>	Description & Color of Materials Sand, Clay, Red Clay, Shell, etc.	Thick- ness Feet	Depth Feet
<u>Rt. 6, Box 295 Jackson, Miss.</u> <small>(Address)</small>	<u>Gravel &amp; Sand</u>	<u>78</u>	<u>78</u>
(2) Location: <u>SW 1/4, NW 1/4, Sec. 6 T11R2W</u>	<u>Sand &amp; Pipe clay</u>	<u>4</u>	<u>82</u>
<u>9</u> miles <u>West</u> of <u>Gallman</u> <small>(distance) (direction) (Nearest Town)</small>	<u>White Water Sand</u>	<u>14</u>	<u>96</u>
(3) Topography: <u>Hilly</u> <small>(Hilly) (Flat) (Level)</small>	<u>Gray Clay</u>	<u>1</u>	<u>97</u>
(4) Purpose of Well: <u>Domestic</u> <small>(Domestic Irrigation Municipal, Industrial, Other)</small>			
<b>Information upon completion of well:</b>			
(1) Diameter: <u>4"</u> inches.			
(2) Total Depth: <u>97</u> feet.			
(3) Water Level: <u>77</u> feet below top of ground.			
(4) Cased to: <u>90'</u> , Size: <u>2"</u>			
(5) Screen: Size: <u>2"</u> , Length: <u>5'</u>			
(6) Were any formations sealed against pollution?  <u>X</u> yes, <u>      </u> no.			
If YES depth of formation <u>      </u> from surface.			
Why to prevent surface pollution <u>      </u>			
Drillers Remarks: <u>Sanitary well seal used</u>			
Yield in gpm: <u>600 Gph with rods</u>			
Size pump: <u>3/4 H. P.</u>			
Type power: <u>Electric</u>			

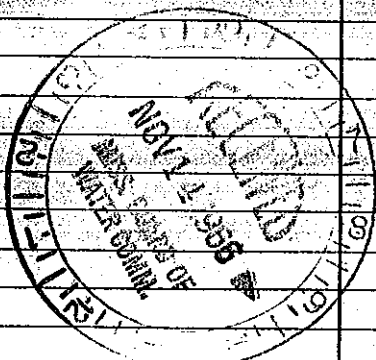

Mail this copy to Board of Water Commissioners 429 Miss. St. Jackson, Miss.