

Copiah
T 39
12-66


MISSISSIPPI BOARD OF WATER COMMISSIONERS

CODED

WATER WELL DRILLERS LOG

Date: Dec. 1, 1966, Driller: Bunny Water Well Service Inc. Copiah
(When well drilled) (Name) (Where well is located)

(1) Owner of Land: <u>Bula Garrett</u> <small>(Name)</small>	Description & Color of Materials Sand, Clay, Red Clay, Shell, etc.	Thick- ness Feet	Depth Feet
<u>Rt. 3, Box 36, Huletts, Miss.</u> <small>(Address)</small>	Top soil & red sand	10	10
(2) Location: <u>1/4 NW 1/4 Sec. 7 T22 N</u>	Gravel & sand	20	30
<u>4</u> miles <u>west</u> of <u>Galena</u> <small>(distance) (direction) (Nearest Town)</small>	Pipe clay	32	62
(3) Topography: <u>Hilly</u> <small>(Hilly) (Flat) (Level)</small>	Clay sand	8	70
(4) Purpose of Well: <u>Domestic</u> <small>(Domestic, Irrigation, Municipal, Industrial, Other)</small>	Pipe clay & sand	22	92
Information upon completion of well:	Coarse Sand & Pea Gravel	19	111
(1) Diameter <u>4</u> inches			
(2) Total Depth <u>111</u> feet			
(3) Water Level <u>96</u> feet below top of ground			
(4) Cased to <u>106</u> Size <u>2"</u>			
(5) Screen: Size <u>2"</u> Length <u>5'</u>			
(6) Were any formations sealed against pollution? <u>X</u> yes, _____ no.			
If YES depth of formation <u>From Surface</u>			
Why <u>To prevent surface pollution</u>			
Drillers Remarks <u>Sanitary well seal used</u>			
Yield in gpm: <u>600 GPH</u>			
Size pump: <u>1 HP</u>			
Type power: <u>Electric</u>			

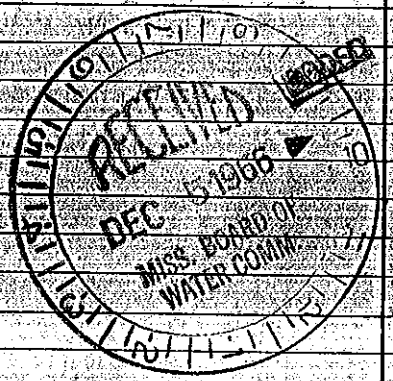

Mail this copy to Board of Water Commissioners 429 Miss. St. Jackson, Miss.