

Copiah

~~T 1-67~~

1-67

MISSISSIPPI
 BOARD OF WATER COMMISSIONERS
 416 North State Street
 Jackson, Mississippi 39201

CODED

WATER WELL DRILLERS LOG

1-23 60 B FORK

Copiah

date well completed firm name county well located


LANDOWNER: R L Miller
PO Box 470
Hazelhurst, Miss
 (mailing address)

WELL LOCATION:
 sec. 30 T 1 N R 2
4 miles NW Hazelhurst
 (distance) (direction) (nearest town)

WELL PURPOSE: Home
 (home, irrigation, municipal, industrial)

WELL COMPLETION DATA:
 (1) diameter (inches) 4
 (2) total depth (feet) 150
 (3) static water level (feet) 114 below top of ground
 (4) casing (material) Galv (depth) 135
2" (size) if telescope see back
 (5) screen 5' (length) 135' (depth to tap)
2" (size) Standard
 (6) pump 2 (HP) 6 (yield gpm)
Electric (type power)
 (7) electric log No (yes or no)
 (organization running log) Baker
 (8) how well bottom plugged

description of formations encountered	from	to
Red Clay loam	0	70
loam	10	13
loam	13	24
Clay loam	24	30
loam	30	40
White cl	40	60
White sh, cl	60	70
cl	70	80
cl	80	84
Rocky sand sh, cl	84	90
sh, cl	90	100
sh - Rocky white	100	110
sh - white	110	120
sh	120	130
sh	130	140
Clay - blue	140	150

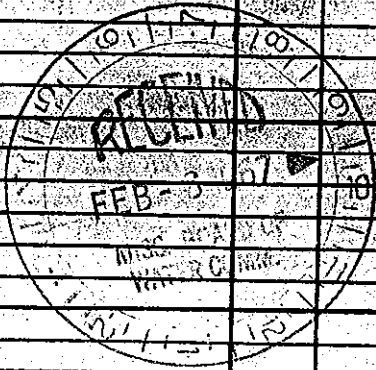

DRILLERS REMARKS: