

COPIA H

MISSISSIPPI BOARD OF WATER COMMISSIONERS

WATER WELL DRILLERS LOG

8-1-62

Date: Aug. 1, 1962 Driller: Burney Water Well Serv. Co. Copiah

(Name)

**CODED**

(1) Owner of Land: Cary McAlpin

(Name)

Crystal Springs, Miss.

(Address)

(2) Location: Thomas Road, 18 NW 1/4 Sec. 18, T. 10 N., R. 4 W.

3 1/2 miles South of Crystal Springs

(distance) (direction) (Nearest Town)

(3) Topography: Hilly

(Hilly) (Flat) (Level)

(4) Purpose of Well: Domestic

(Domestic, Irrigation, Municipal, Industrial, Other)

Information upon completion of well:

(1) Diameter: 6 inches

(2) Total Depth: 138 feet

(3) Water Level: 91 feet below top of ground

(4) Cased to 128' Size 2 1/2" - 2 1/2"

(5) Screen Size: 2 1/2" Length: 10'

(6) Were any formations sealed against pollution?


yes,  no.

If YES depth of formation: From surface

Why To prevent surface pollution

Drillers Remarks: Used sanitary well seal

**CODED**

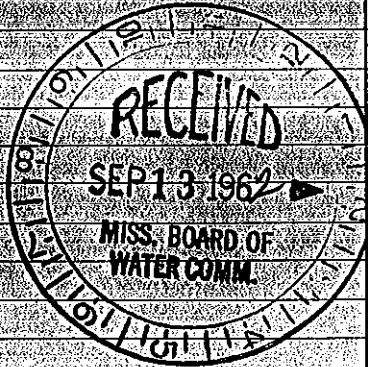

(Use Back Side)

Well No

Mail this copy to Board of Water Commissioners 429 Miss. St. Jackson, Miss.