

COPIAH MISSISSIPPI BOARD OF WATER COMMISSIONERS

J 51  
2-26-63

WATER WELL DRILLERS LOG

CODED

Date: Feb. 26, 1963, Driller: Burney Water Well Co. Copiah

(Name)

(1) Owner of Land: Daniel B. Fielder  
(Name)

Route 3, Crystal Springs, Miss.  
(Address)

(2) Location: Highway 51 South  
1/4 SW 1/4, Sec. 2 T1N2W

3 miles South of Crystal Springs  
(distance) (direction) (Nearest Town)

(3) Topography: Hilly  
(Hilly) (Flat) (Level)

(4) Purpose of Well: Domestic  
(Domestic Irrigation  
Municipal, Industrial, Other)


Description & Color of Materials Sand, Clay, Red Clay, Shell, etc.	Thick- ness Feet	Depth Feet
Topsoil & clay	6	6
Sand rock	1	7
Clay & sand gravel	33	40
Red sand & gravel	24	64
Clay gravel	14	78
Sand rock	1	79
Gravel & Pipe clay	13	92
Pea gravel & Sand	11	103
All white sand	21	124

Information upon completion of well:

- (1) Diameter 4 inches.
- (2) Total Depth 124 feet.
- (3) Water Level 96 feet below top of ground.
- (4) Cased to 123' Size 2"
- (5) Screen: Size 24", Length 5'
- (6) Were any formations sealed against pollution?  
X yes, no.

If YES depth of formation From Surface  
Why To prevent surface pollution

Drillers Remarks:

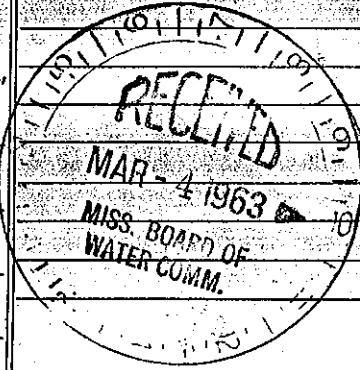

(Use Back Side)

Well No.

ail this copy to Board of Water Commissioners 429 Miss. St. Jackson, Miss