


COPIAH MISSISSIPPI BOARD OF WATER COMMISSIONERS

J 56  
10-6-65

WATER WELL DRILLERS LOGS

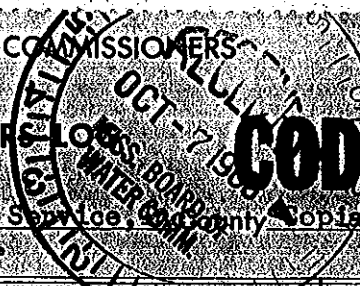

**CODED**

Date: Oct. 6, 1965 Driller: Burney Well Service, Copiah County, Miss.

5523

(1) Owner of Land: Howard McGlendon (Name)	Description & Color of Material Sand, Clay, Red Clay, Shell, etc.	Thick- ness Feet	Depth Feet
Rt. 3, Box 77, Crystal Springs (Address)	Sand & Gravel	46	46
Millsaps Road (2) Location: 1/4 Sec. 7, 120	Sand, Layers of clay	4	50
7 miles west of Crystal Springs (distance) (direction) (Town)	Sand rock	1	51
(3) Topography: hilly (Hilly) (Flat) (Level)	Yellow & Grey clay	17	68
(4) Purpose of Well: domestic (Domestic Irrigation Municipal, Industrial, Other)	Rock	6	74
	Hard limestone	5	79
	Blue clay	7	86
	Sand layers	22	108
	All medium sand	8	116
	Shale	2	118

Information upon completion of well:

(1) Diameter: 4 inches

(2) Total Depth: 118 feet

(3) Water Level: 92' feet below top of ground

(4) Cased to: 112' Size: 2"

(5) Screen: Size 2" Length 5'

(6) Were any formations sealed against pollution?  
 yes,  no

If YES depth of formation from surface

Why to prevent surface pollution

Drillers Remarks: well seal used

**CODED**

Well No.

(Use Back Side)

Mail this copy to Board of Water Commissioners 429 Miss. St. Jackson, Miss.