

COPIAH MISSISSIPPI BOARD OF WATER COMMISSIONERS

J 2003
6-15-61

WATER WELL DRILLERS LOG

Date: June 15, 1961 Driller: Burney Water Well Serv. County Copiah

(Name)

	Description & Color of Materials Sand, Clay, Red Clay, Shell, etc.	Thick- ness Feet	Depth Feet
(1) Owner of Land: <u>Gallman Chapel M.E. Church</u> (Name)	Topsoil & clay	6	6
<u>Gallman, Miss.</u> (Address)	Clay, sand & gravel	48	54
(2) Location: <u>Highway 51 10 N 2W</u> 1/4, 1/4, Sec. T R	Pipe clay	4	58
<u>1 1/4</u> miles <u>North</u> of <u>Gallman</u> (distance) (direction) (Nearest Town)	Gravel & sand	68	126
(3) Topography: <u>Hilly</u> (Hilly) (Flat) (Level)	Pea gravel & coarse sand	12	138
(4) Purpose of Well: <u>Domestic</u> (Domestic Irrigation Municipal, Industrial, Other)	Hard clay	2	140

Information upon completion of well:

(1) Diameter 4 inches

(2) Total Depth 140 feet

(3) Water Level 94 feet below top of ground

(4) Cased to 133' Size 2"


(5) Screen Size 2" Length 5'

(6) Were any formations sealed against pollution?
 yes, no.

If YES depth of formation From surface

Why To prevent surface pollution

Drillers Remarks:

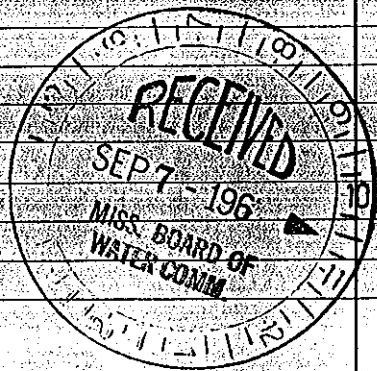

(Use Back Side)

Well No.

Mail this copy to Board of Water Commissioners 429 Miss. St. Jackson, Miss.