


COPIAH MISSISSIPPI BOARD OF WATER COMMISSIONERS

J 2006  
12-8-62

WATER WELL DRILLERS LOG

Date: Dec. 8, 1962, Driller: Burney Water Well Serv County: Copiah  
(Name)

(1) Owner of Land: <u>Ward Gallman</u> (Name)	Description & Color of Materials Sand, Clay, Red Clay, Shell, etc.	Thick- ness Feet	Depth Feet
<u>Crystal Springs, Miss.</u> (Address)	Red topsoil	4	4
<u>Highway 51 South</u> (Address)	Sand & gravel	36	40
(2) Location: <u>1/4, 1/4, Sec. 10-1-22W</u>	Red sand	10	50
<u>4 miles South</u> of <u>Crystal Springs</u> (distance) (direction) (Nearest Town)	Big clay gravel	36	86
(3) Topography: <u>Level</u> (Hilly) (Flat) (Level)	Fine white sand	9	95
(4) Purpose of Well: <u>Domestic</u> (Domestic Irrigation Municipal, Industrial, Other)	Med. sand	7	102
Information upon completion of well:	Coarse sand & pea gravel	21	123
(1) Diameter <u>6</u> inches.	Hard rock	1	124
(2) Total Depth <u>124</u> feet.			
(3) Water Level <u>86</u> feet below top of ground.			
(4) Cased to <u>102 1/2'</u> , Size <u>4"</u>			
(5) Screen: Size <u>2 1/2"</u> , Length <u>10'</u>			
(6) Were any formations sealed against pollution? <u>X</u> yes, <u>      </u> no.			
If YES depth of formation from surface <u>      </u>			
Why to prevent surface pollution <u>      </u>			
Drillers Remarks: <u>used Sanitary well seal</u>			

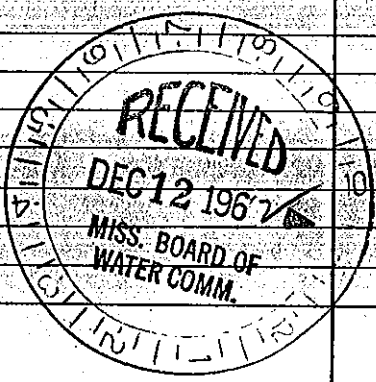

Well No

(Use Back Side)

Mail this copy to Board of Water Commissioners 429 Miss. St. Jackson, Miss