

COPIAH MISSISSIPPI BOARD OF WATER COMMISSIONERS

E J 2008  
7-2-63

**WATER WELL DRILLERS LOG**

Date: July 2, 19 63, Driller: Ben Burney County Copiah

(1) Owner of Land Mr. B. W. Mathis, Jr.  
(Name)

Mathis Road, Crys. Spg.  
(Address)

(2) Location:  $\frac{1}{4}$ ,  $\frac{1}{4}$ ,  $\frac{1}{4}$ ,  $\frac{1}{4}$  Sec. 12W T. R.  
4 miles South of Cry. Spg.  
(distance) (direction) (Nearest Town)

(3) Topography: Hilly  
(Hilly) (Flat) (Level)

(4) Purpose of Well: Domestic  
(Domestic Irrigation Municipal, Industrial, Other)

<small>Description &amp; Color of Materials Sand, Clay, Red Clay, Shell, etc.</small>	<small>Thick- ness Feet</small>	<small>Depth Feet</small>
<u>Red Top Soil</u>	<u>12</u>	<u>12</u>
<u>Red Sand</u>	<u>18</u>	<u>30</u>
<u>Gravel, Clay, &amp; Sand</u>	<u>50</u>	<u>80</u>
<u>Water Sand</u>	<u>6</u>	<u>86</u>
<u>Layers Clay &amp; Fine Sand</u>	<u>12</u>	<u>98</u>
<u>All Sand</u>	<u>20</u>	<u>118</u>
<u>Best Peg Gravel 105 to 116</u>		

Information upon completion of well:

(1) Diameter: 6 inches.

(2) Total Depth: 118 feet.

(3) Water Level: 67 feet below top of ground.

(4) Cased to: 109' Size: 4"


(5) Screen: Size: 4" Length: 7'

(6) Were any formations sealed against pollution?  
 yes,  no.

If YES depth of formation: From surface

Why to prevent surface pollution: \_\_\_\_\_

Drillers Remarks: \_\_\_\_\_

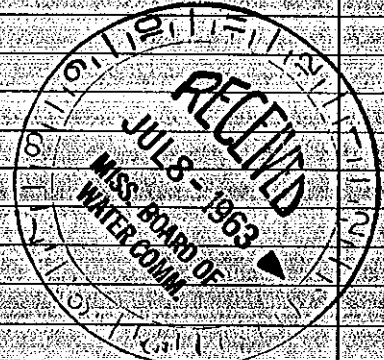

(Use Back Side)

Well No. \_\_\_\_\_