


COPIA

MISSISSIPPI BOARD OF WATER COMMISSIONERS

J 2012  
8-24-64

WATER WELL DRILLERS LOG

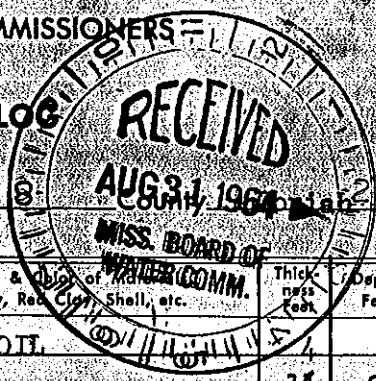

Date: 8-21-64, 1964, Driller: Ben Burrey

(Name)

(1) Owner of Land: W. H. Neuenfeld  
(Name)

Rt. 2, Hazlehurst, Mississippi  
(Address)

(2) Location: 1/4, 2 1/4 Sec. 1 EW T. 1 R.  
5 miles Northeast of Hazlehurst  
(distance) (direction) (Nearest Town)

(3) Topography: Hilly  
(Hilly) (Flat) (Level)

(4) Purpose of Well: Domestic  
(Domestic, Irrigation, Municipal, Industrial, Other)

Description & Kind of Sand, Clay, Red Clay, Shell, etc.	Thickness Feet	Depth Feet
RED TOP SOIL	4	4
RED SAND	16	20
SAND & GRAVEL	6	26
PIPE CLAY	17	43
CLAY & SAND LAYERS	39	82
HARD GREY CLAY	13	95
HARD Limestone	7	102
GREY SHALE	3	105
FINE SAND	6	111
GREY CLAY	3	114
SAND & CLAY LAYERS	10	124
HARD SHALE	6	130

Information upon completion of well:

- (1) Diameter 6 inches.
- (2) Total Depth 113 feet.
- (3) Water Level 67' feet below top of ground.
- (4) Cased to 106', Size 4"
- (5) Screen: Size 4", Length 5'
- (6) Were any formations sealed against pollution?  
 yes,  no.

If YES depth of formation from surface  
Why to prevent surface pollution

Drillers Remarks:

(Use Back Side)

Well No.

Retain this copy for your office files.