

COPIAH

MISSISSIPPI BOARD OF WATER COMMISSIONERS


J 2013  
3-19-66

WATER WELL DRILLERS LOG

Date: 3-19, 1966, Driller: *Chas. Ottobach* County: *Copiah*

(Name)

(1) Owner of Land	Description & Color of Materials Sand, Clay, Red Clay, Shell, etc.	Thick- ness Feet	Depth Feet
<i>Jessie Foster</i> (Name) <i>Hogchuck miss</i> (Address)	<i>0-22 clay</i> <i>22-81 sand &amp; gravel</i>		
(2) Location: <i>1/4</i> , <i>19 1 2W</i> Sec. T. R.			
<i>4</i> miles <i>N. W.</i> of <i>Hogchuck</i> (distance) (direction) (Nearest Town)			
(3) Topography: <i>Hilly</i> (Hilly) (Flat) (Level)	<i>Drilling 7 gal.</i> <i>per minute</i>		
(4) Purpose of Well: <i>Home</i> (Domestic Irrigation Municipal, Industrial, Other)			
Information upon completion of well:			
(1) Diameter <i>2</i> inches.			
(2) Total Depth <i>81</i> feet.			
(3) Water Level <i>68</i> feet below top of ground.			
(4) Cased to <i>74</i> , Size <i>2"</i>			
(5) Screen: Size <i>2"</i> , Length <i>5'</i>			
(6) Were any formations sealed against pollution?			
yes, <i>NO</i> no.			
If YES depth of formation _____			
Why _____			
Drillers Remarks: _____			
_____			
_____			
_____			

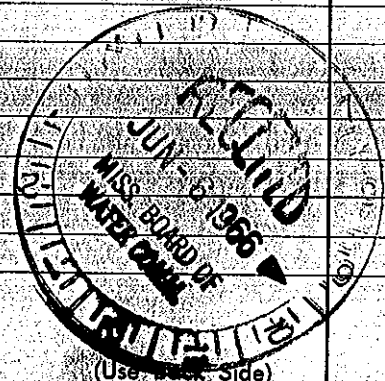

Well No.

Mail this copy to Board of Water Commissioners 429 Miss. St. Jackson, Miss.