

COPIAH

MISSISSIPPI BOARD OF WATER COMMISSIONERS

J 2014  
7-15-66

WATER WELL DRILLERS LOG

Inc.


Date: July 15, 1966, Driller Burney Water Well Service County Copiah

(Name)

(1) Owner of Land: Frank Alexander  
(Name)  
Route 3, Box 20-A  
(Address)  
(2) Location: 5 1 2N  
5 miles S-West of Crystal Springs  
(distance) (direction) (Township)  
(3) Topography: Hilly  
(Hilly) (Flat) (Level)  
(4) Purpose of Well: Domestic  
(Domestic Irrigation  
Municipal, Industrial, Other)

Description & Color of Materials Sand, Clay, Red Clay, Shell, etc.	Thick- ness Feet	Depth Feet
Red top soil	10	10
Red Sand	11	21
Gravel & Sand	19	40
Red Sand & gravel, <u>Pipe Clay</u>	30	70
Pea Gravel & Sand	10	80
Clay	2	82

Information upon completion of well:  
(1) Diameter 4" inches.  
(2) Total Depth 82 feet.  
(3) Water Level 68 feet below top of ground.  
(4) Cased to 77', Size 2"  
(5) Screen: Size 2", Length 5'  
(6) Were any formations sealed against pollution?  
X yes, \_\_\_ no.  
If YES depth of formation From surface  
Why to prevent surface pollution  
Drillers Remarks: Sanitary well seal used.

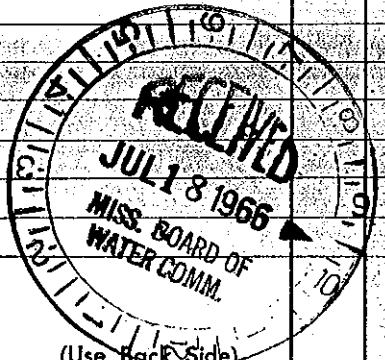

Well No.

ail this copy to Board of Water Commissioners 429 Miss. St. Jackson, Miss.