

**MISSISSIPPI DEPARTMENT OF NATURAL RESOURCES**

Bureau of Land and Water Resources

COUNTY WELL LOCATED <b>Copiah</b>	
WELL NUMBER <b>77199</b>	CODED
<b>J 2023</b>	
DATE WELL COMPLETED <b>8-13-96</b>	

PERMIT NUMBER <b>510</b>
NAME OF DRILLING FIRM <b>Easley Water Wells</b>
<b>Brookhaven, MS 39601</b>

P.O. Box 10631  
Jackson, Mississippi 39209  
**WATER WELL DRILLERS LOG**

NAME & MAILING ADDRESS OF LANDOWNER <b>Mr. Pruitt</b>			
WELL LOCATION:	SEC <b>36</b>	TOWNSHIP <b>N 2</b>	RANGE <b>2 E</b>
DISTANCE	DIRECTION <b>IN</b>	NEAREST TOWN	
OTHER LANDMARK			
WELL PURPOSE: Home, Irrigation, Municipal, Industrial, Fish Pond, etc.			

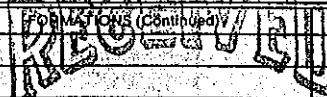
<b>PUMP DATA</b>		
PUMP TYPE (Circle One): <input checked="" type="checkbox"/> Submersible, <input type="checkbox"/> Turbine, <input type="checkbox"/> Jet, <input type="checkbox"/> Flowing Well, Other (Describe)		
POWER TYPE (Circle One): <input checked="" type="checkbox"/> Electric, <input type="checkbox"/> Tractor, <input type="checkbox"/> Diesel, <input type="checkbox"/> Gasoline, <input type="checkbox"/> Butane, Other (Describe)		
Pump Capacity (GPM)	No. of Stages	Setting Depth  <b>FT.</b>
PUMP TEST		
Well yielded _____ GPM with a drawdown of _____ ft. after _____ hours of pumping		

<b>WELL DATA</b>		
Well Depth <b>110'</b>	Casing Diameter (In.) <b>4"</b>	Casing Length (Ft.) <b>90'</b>
Type of Casing <b>PVC</b>	Hole Depth <b>120'</b>	Depth to Static Water Level
TYPE OF COMPLETION: (Circle One or More): <input checked="" type="checkbox"/> Gravel Packed, <input type="checkbox"/> Underreamed, <input type="checkbox"/> Telescoped, <input checked="" type="checkbox"/> Natural Development, <input type="checkbox"/> Open Hole, <input type="checkbox"/> Other (Describe)		
Top of Lap Pipe or Reduction in Casing <b>FEET: IF TELESCOPED OR MORE THAN ONE SCREEN: USE BACK PAGE</b>		

<b>LOG DATA</b>	
TYPE OF LOG RUN (Circle One): <input type="checkbox"/> No Log Run, <input type="checkbox"/> Electric, <input type="checkbox"/> Gamma Ray, <input type="checkbox"/> Density, <input type="checkbox"/> Sonic, <input type="checkbox"/> Neutron, Other (Describe)	
Name of Organization Running Log	

<b>SCREEN DATA</b>		
Diameter - Inches <b>4"</b>	Length - Feet <b>20'</b>	Slot Size - Inches <b>10</b>
Screen Type <b>PVC</b>	Depth to Bottom - Feet <b>110'</b>	

<b>GEOLOGIC DATA (Office Use Only)</b>			
Surface Elev.	Geologic Unit	Unit Thickness	Depth to Top
Subs. SWL	Date	Analysis	Aquifer Test
Driller's Remarks			

DESCRIPTION OF FORMATIONS ENCOUNTERED	FROM	TO	FORMATIONS (Continued)	FROM	TO
Clay	0	20	 <b>AUG 19 1997</b> Dept. of Environmental Quality Office of Land & Water Resources		
Gravel	20	60			
Stripy sand	60	90			
Sand	90	110			
Clay	110	120			

IF MORE SPACE IS NEEDED, USE BACK