

Copiah
K 15
9-66

MISSISSIPPI BOARD OF WATER COMMISSIONERS

M. J. G.
COPIAH

WATER WELL DRILLERS LOG


Date: September 12, 1966 Driller: Burney Water Well Service, Inc. Copiah County, Copiah

(1) Owner of Land: George Sykes
(Name)
Route 2
(Address)
(2) Location: NE 1/4, NE 1/4, Sec. 11, T18R14
7 miles S east of Crystal Springs
(distance) (direction) (Name)
(3) Topography: Hilly
(Hilly) (Flat) (Level)
(4) Purpose of Well: Domestic
(Domestic Irrigation, Municipal, Industrial, Other)

Description & Color of Materials (Sand, Clay, Red Clay, Shell, etc.)	Thickness Feet	Depth Feet
Red Top soil	6	6
Red Sand	44	50
White sand	12	62
White clay in layers	22	84
Layers sand & clay	26	110
Pea gravel	2	112
Rock	2	114
layers clay & Sand	12	126
Fine quick sand	18	144
layers clay & sand	30	174
Hard rock	3	177
Blue shale	5	182
Rock or Limestone	2	184
Blue shale	18	202

Information upon completion of well:
(1) Diameter: 4" inches
(2) Total Depth: 202 feet
(3) Water Level: 102 feet below top of ground
(4) Cased to: 134' Size: 2"
(5) Screen Size: 2" Length: 5'
(6) Were any formations sealed against pollution?
X yes, no

If YES depth of formation From surface
Why to prevent surface pollution
Drillers Remarks: Sanitary well seal used

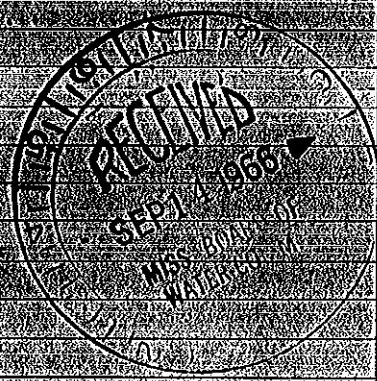

(Use Back Side)

Well No.