

COPIA

MISSISSIPPI BOARD OF WATER COMMISSIONERS

K 17

2-25-66

WATER WELL DRILLERS LOG

CODED

Date: 2/25 1966 Driller: Burrey Water Well Serv. Co. Inc. County: Copiah

(1) Owner of land: Paul Knight  
(Name)  
Rt. 2, Crystal Springs, Miss.  
(Address)

(2) Location: 1/4 Sec. 8 T. 11 N. R. 14 W.  
5 mile South-east of Crystal Springs  
(distance) (direction) (town)

(3) Topography: Hilly  
(Hilly) (Flat) (Level)

(4) Purpose of Well: Domestic  
(Domestic) (Irrigation) (Municipal) (Industrial) (Other)

Description of Color of Materials Sand, Clay, Red Clay, Shell, etc.	Thickness Feet	Depth Feet
Red Top soil	11	11
Red sand & gravel	59	70
Smear of water sand	12	82
Pea gravel & pipe clay	20	102
Grey clay	15	117
Water sand	19	136

Information upon completion of well

(1) Diameter: 4 inches

(2) Total Depth: 136 feet

(3) Water Level: 62 feet below top of ground


(4) Cased to: 122 Size: 1 1/2

(5) Screen Size: 1/2 length: 12

(6) Were any formations sealed against pollution?  
 yes,  no.

If YES, depth of formation from surface  
Why to prevent surface pollution

Drillers Remarks: Sanitary well sealed.

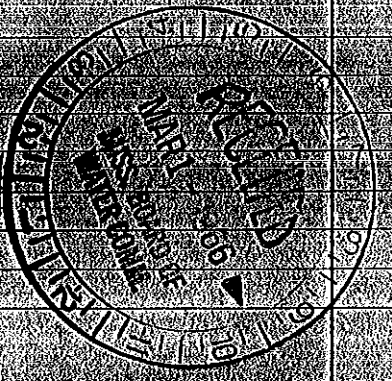

(Use Back Side)

Well No.